

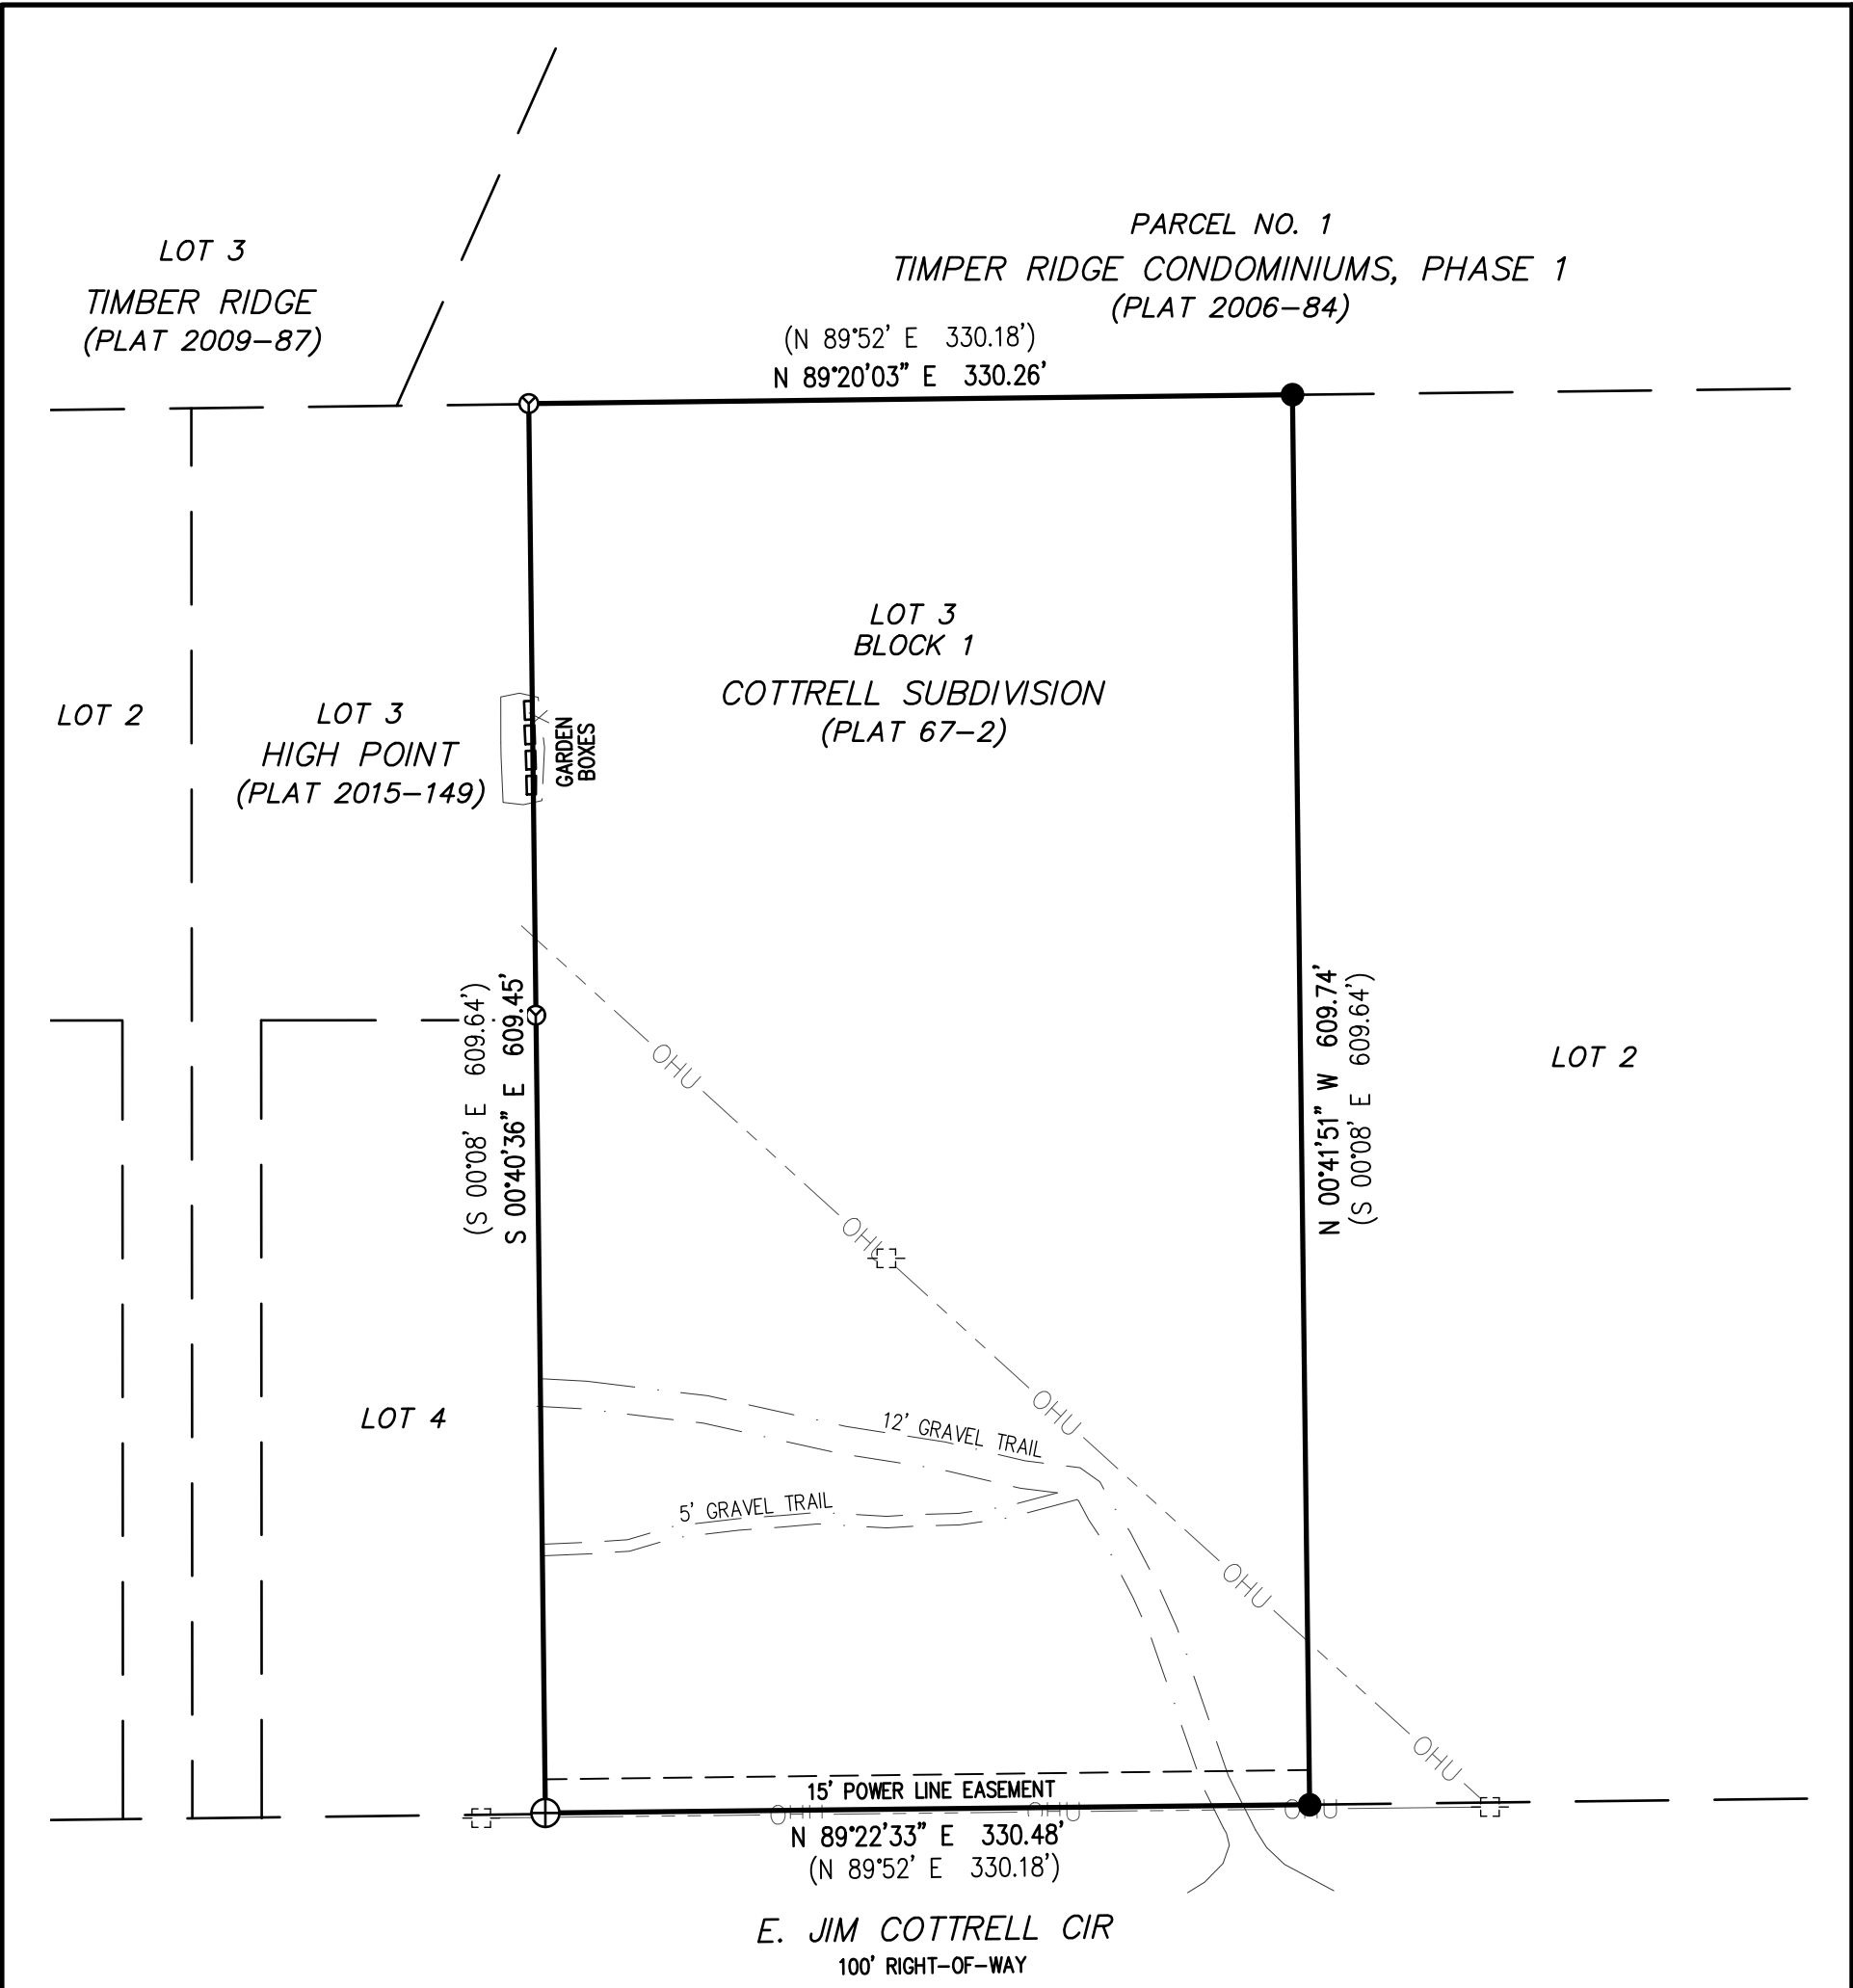


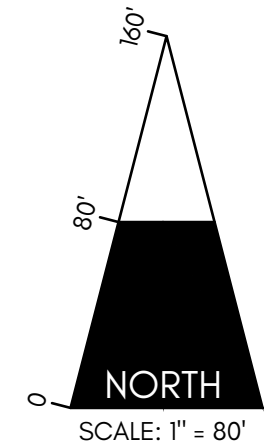

LEGEND

- ⊕ FOUND REBAR WITH PLASTIC CAP
- FOUND REBAR
- [-] POWER POLE
- - - - - OHU - OVERHEAD UTILITY
- - - - - X - 6' WIRE FENCE

- NOTES
- DIMENSIONS ARE RECORD PER PLAT 67-2.
 - UTILITIES OTHER THAN THOSE SHOWN MAY EXIST.
 - ALL VISIBLE ABOVE GROUND FEATURES OF THE EXISTING SEPTIC SYSTEM WERE LOCATED AT THE TIME OF SURVEY AND SHOWN HERE ON.

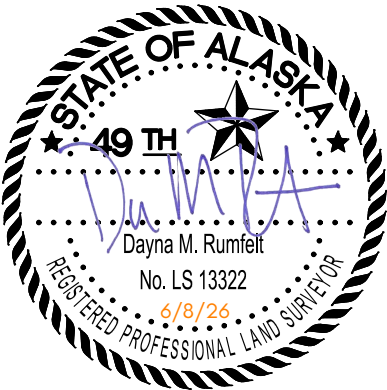

ASBUILT – TWO CORNERS SET THIS DATE	
I HEREBY CERTIFY THAT I HAVE PERFORMED A SURVEY OF	
LOT 3, BLOCK 1, COTTRELL SUBDIVISION, PLAT No. 67-2, PALMER RECORDING DISTRICT, ALASKA,	
AND THAT THE IMPROVEMENTS AS DEPICTED HEREON EXIST AS SHOWN IN RELATION TO THE PROPERTY LINES. EASEMENTS OF RECORD OTHER THAN THOSE SHOWN ON RECORDED PLAT No. 67-2 ARE NOT SHOWN HEREON UNLESS OTHERWISE NOTED.	
DATE: 6/8/2026	FB: 2026-03
GRID: WA09	DRAWN: AP/DMR
SCALE: 1" = 80'	FILE: 26-206AB