


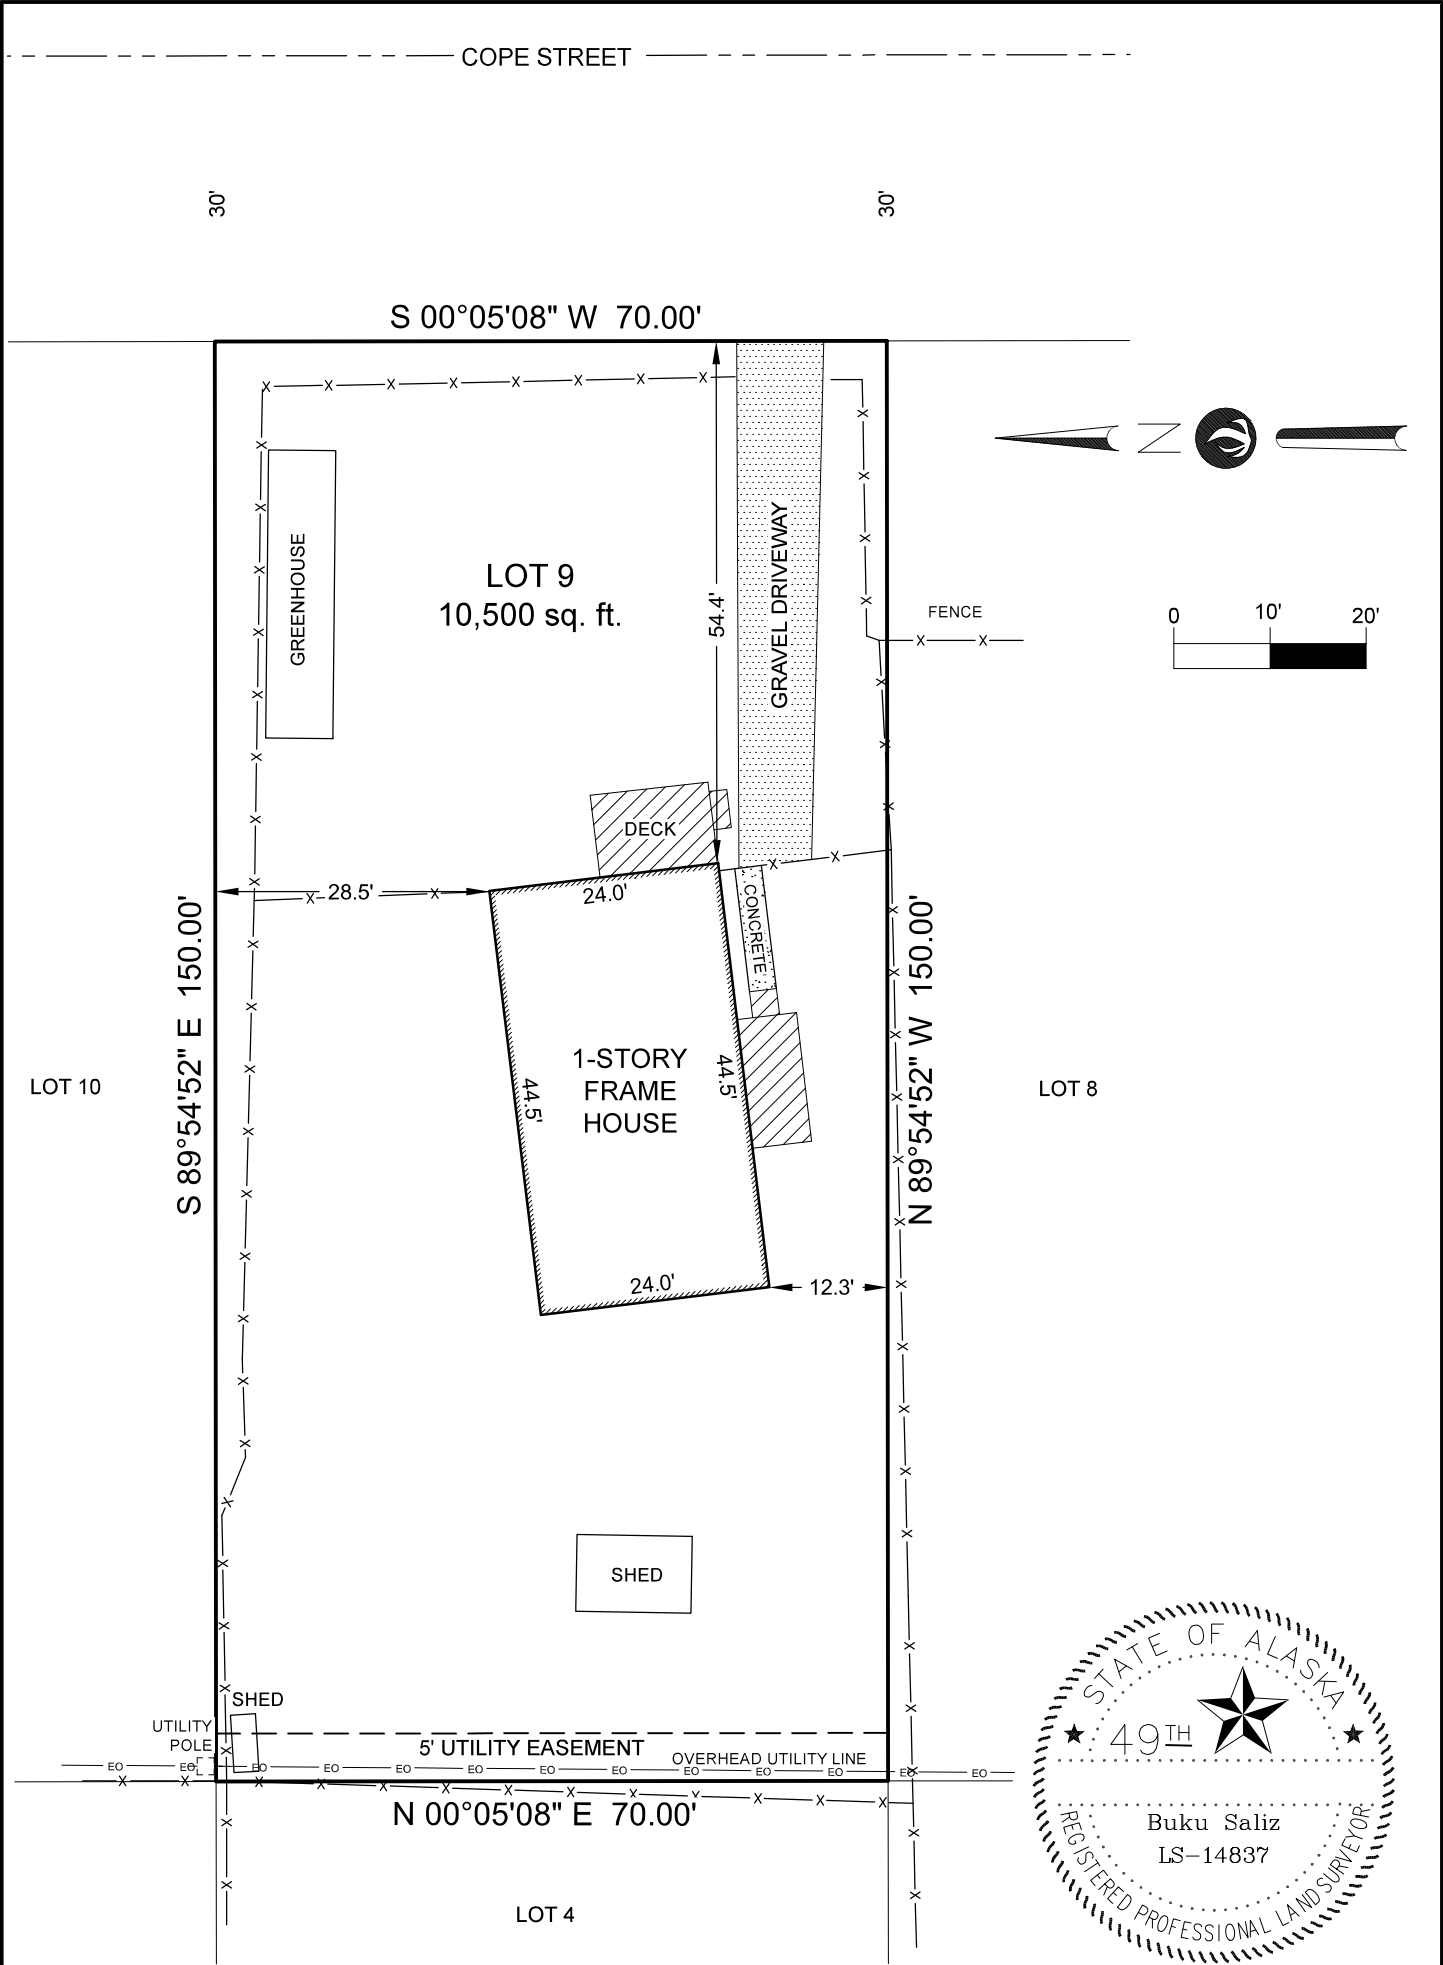

EASEMENTS OF RECORD, OTHER THAN THOSE SHOWN ON THE RECORDED SUBDIVISION PLAT (P-284) ARE NOT SHOWN HEREON. THIS DOCUMENT DOES NOT CONSTITUTE A BOUNDARY SURVEY AND IS SUBJECT TO ANY INACCURACIES THAT A SUBSEQUENT BOUNDARY SURVEY MAY DISCLOSE. UNDER NO CIRCUMSTANCES SHOULD ANY OF THE DATA HEREON BE USED FOR CONSTRUCTION OF FENCES, IMPROVEMENTS, OR FOR ESTABLISHING PROPERTY BOUNDARIES. THIS SURVEY REPRESENTS A MORTGAGE LOCATION SURVEY PREPARED IN ACCORDANCE WITH THE ASPLS MORTGAGE LOCATION SURVEY STANDARDS.

THIS MORTGAGE LOCATION SURVEY SHOULD ONLY BE USED FOR A SINGLE PROPERTY TRANSACTION. RE-USE OF THIS DRAWING BY THE ORIGINAL CLIENT OR BY OTHERS, FOR ADDITIONAL USES AT A LATER DATE WITHOUT EXPRESS CONSENT OF THE SURVEYOR IS A VIOLATION OF FEDERAL COPYRIGHT LAW. UNLESS GROSS NEGLIGENCE IS DISCOVERED, THE LIABILITY EXTENT OF THE PREPARER SHALL BE LIMITED TO THE AMOUNT OF FEES COLLECTED FOR SERVICES IN PREPARATION OF THIS PRODUCT.

AS-BUILT

I HEREBY CERTIFY THAT I HAVE SURVEYED THE FOLLOWING DESCRIBED PROPERTY:

LOT 9, BLOCK I, SPERSTAD SUBDIVISION

ANCHORAGE RECORDING DISTRICT, ALASKA AND THAT THE VISIBLE IMPROVEMENTS SITUATED THEREON ARE WITHIN THE PROPERTY LINES AND NO VISIBLE ENCROACHMENTS EXIST EXCEPT AS INDICATED.

DATED THIS 2nd DAY OF JULY, 2026, AT ANCHORAGE, ALASKA.

FIXED HEIGHT, LLC

Land Surveying Services
600 W 41st. Ave, Ste. C, Anchorage, AK 99503

WWW.FIXEDHEIGHT.COM
907.290.8949

C.O.A. 122554