

Chenhall Surveying



P.O. Box 6522 ♦ Ketchikan, AK 99901
Phone 907-225-9555

AS-BUILT SURVEY

Project #283.05

USS 2604, Lot 19AB

Scale: 1" = 50'


Date: 5/19/04

FOR

Bill Seabolt

Box 1201

Ward Cove, AK 99928

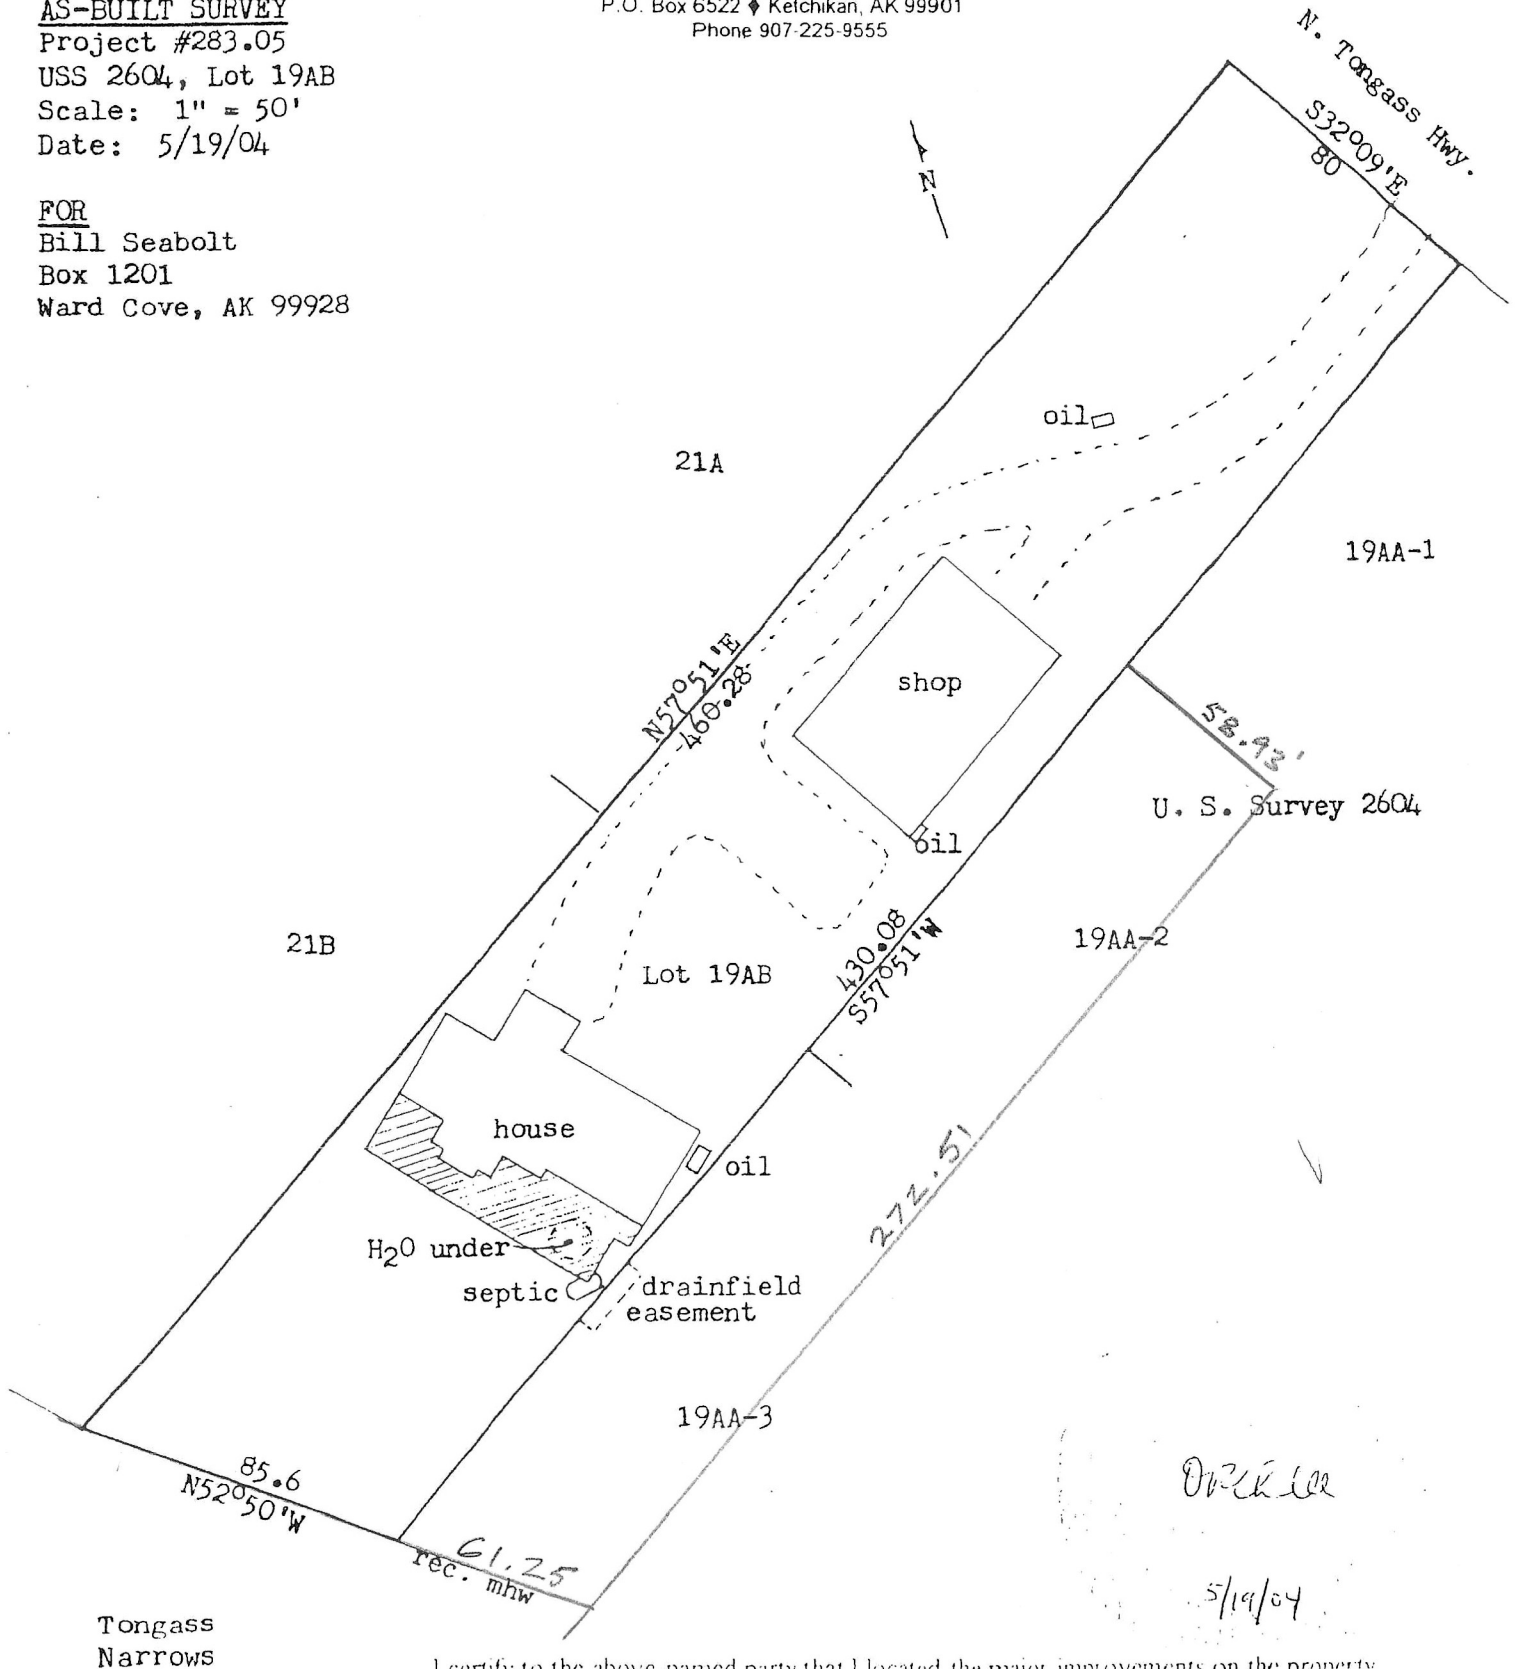

I certify to the above-named party that I located the major improvements on the property depicted above, and that there are no visible boundary encroachments except as indicated. Record distances and bearings are shown. The owner is responsible for determining the existence of any easements, covenants or restrictions that don't appear on the recorded subdivision plat. Under no circumstances may information contained hereon be used for the location of fences or boundary lines. This survey is void if altered or updated by others.