


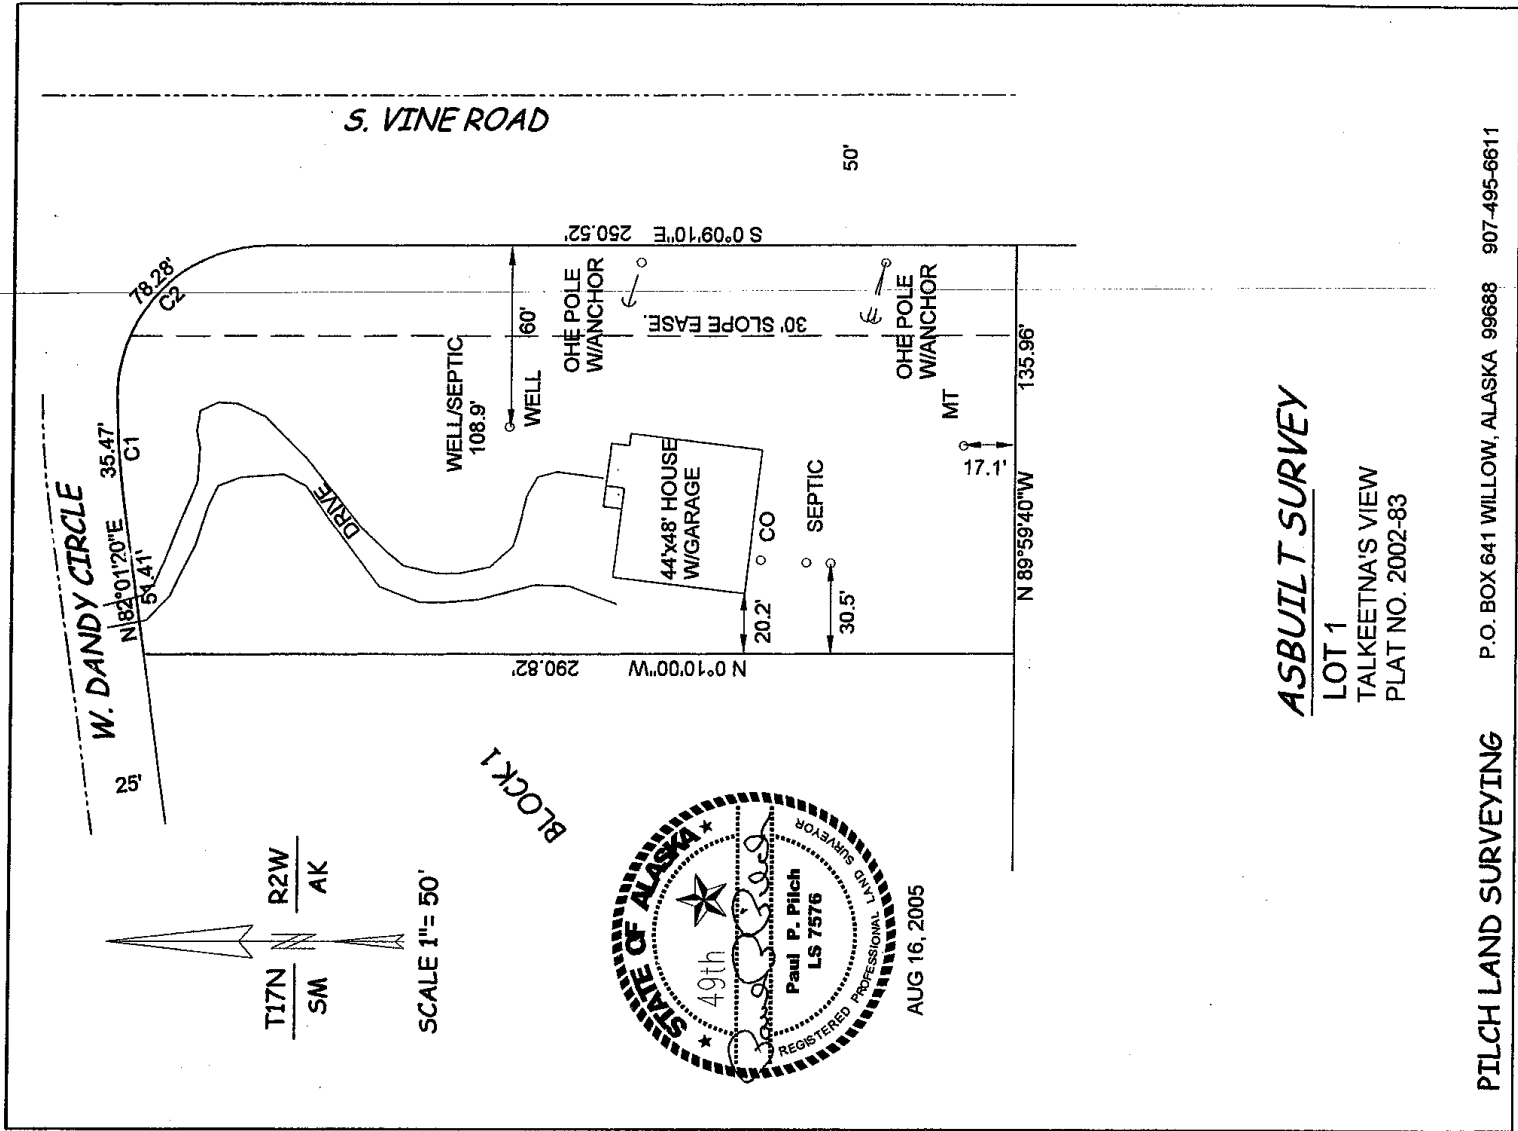

ASBUILT SURVEY

LOT 1
TALKEETNA'S VIEW
PLAT NO. 2002-83