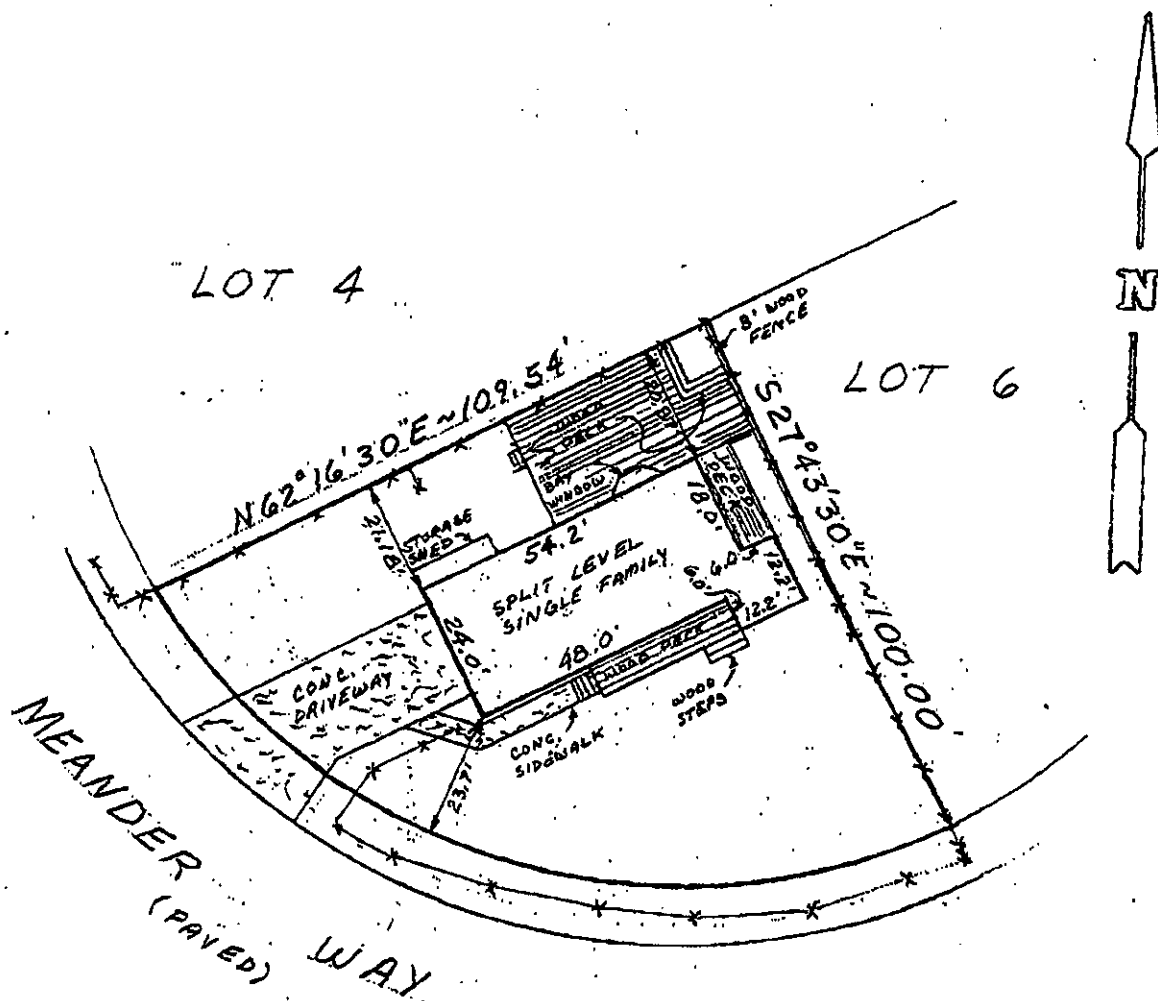
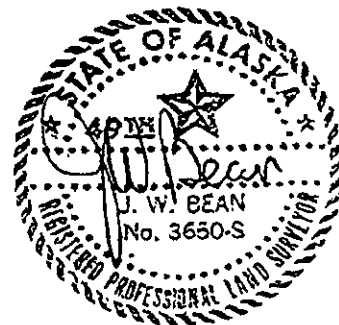


CURVE DATA $\Delta = 84^{\circ} 47' 02''$  $R = 110.00'$  $T = 100.42'$  $L = 162.77'$  $CHORD = N 75^{\circ} 18' 58'' W - 148.32'$ 

I hereby certify that this is a true and correct plat;  
 that all walks, roads, easements, and improvements thereon  
 are as shown and that all overlaps and encroachments are  
 as shown to the best of my knowledge.

**J. W. BEAN**

PROFESSIONAL SURVEYOR

4528 SAWA CIRCLE

JUNEAU, ALASKA

907-789-0580

SURVEYOR - PLANNER

AS-Built Survey of  
 Lot 5, Block C  
 Lakewood Sub. No III  
 within U.S.S. 4598

|          |               |              |
|----------|---------------|--------------|
| DES. JWB | JOB No. 10795 | SCALE 1"=30' |
| P.B.     | DATE 6-6-91   | SHEET 1 OF 1 |