




Bean Creek Rd.

Ptarmigan Pl.

Raven St.

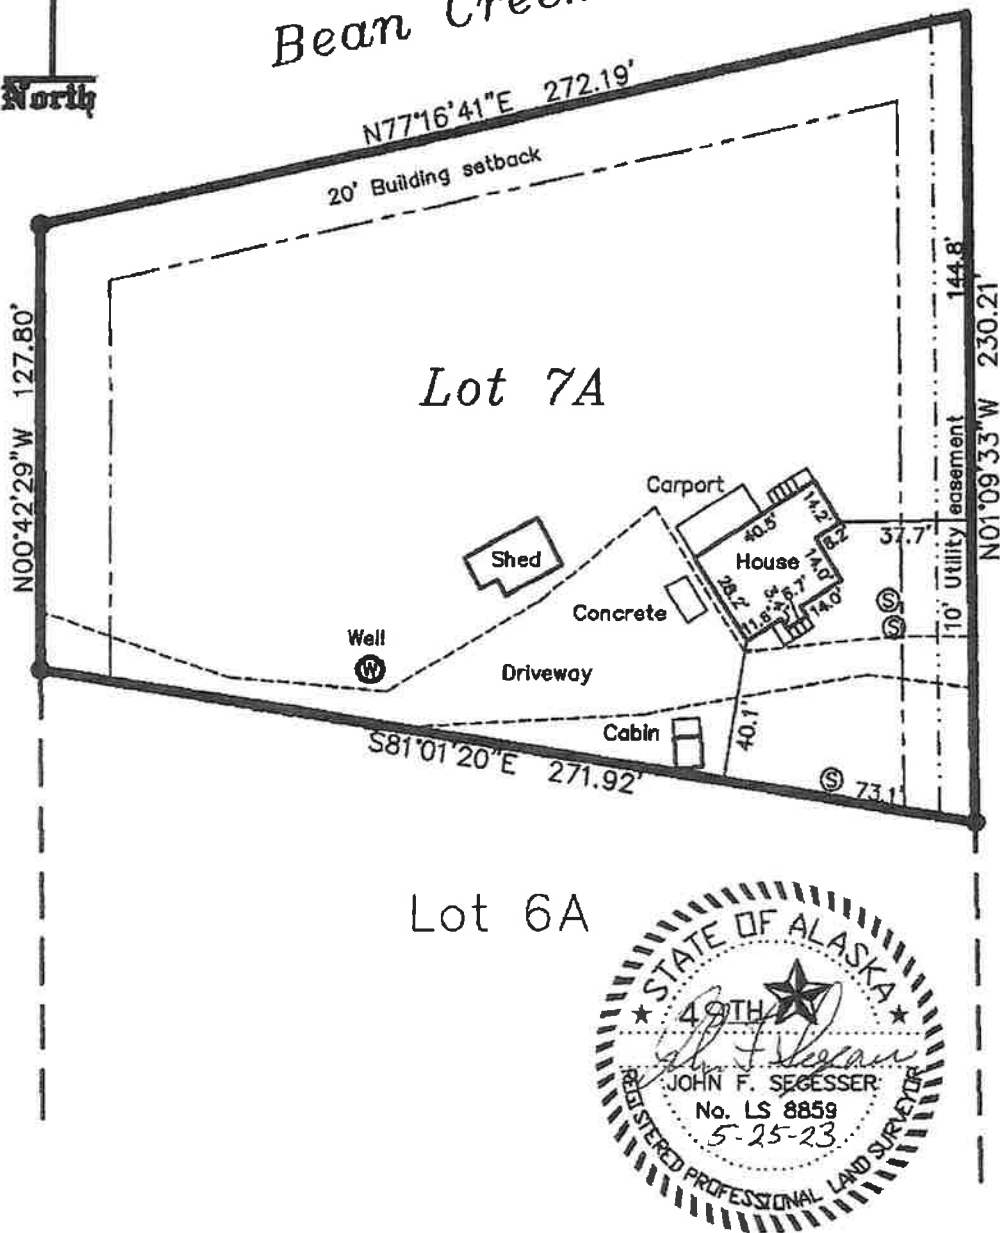

ASBUILT CERTIFICATION

LEGEND

- Found Rebar
- Ⓢ Sewer vent

I hereby certify that I have surveyed the following described property:

Lot 7A

Recreation Estates Subd. Herbert Addn.

and that no encroachments exist except as indicated.

KENAI RECORDING DISTRICT

Plat: 2009-14