


NOTE: See Resolution 2021-18

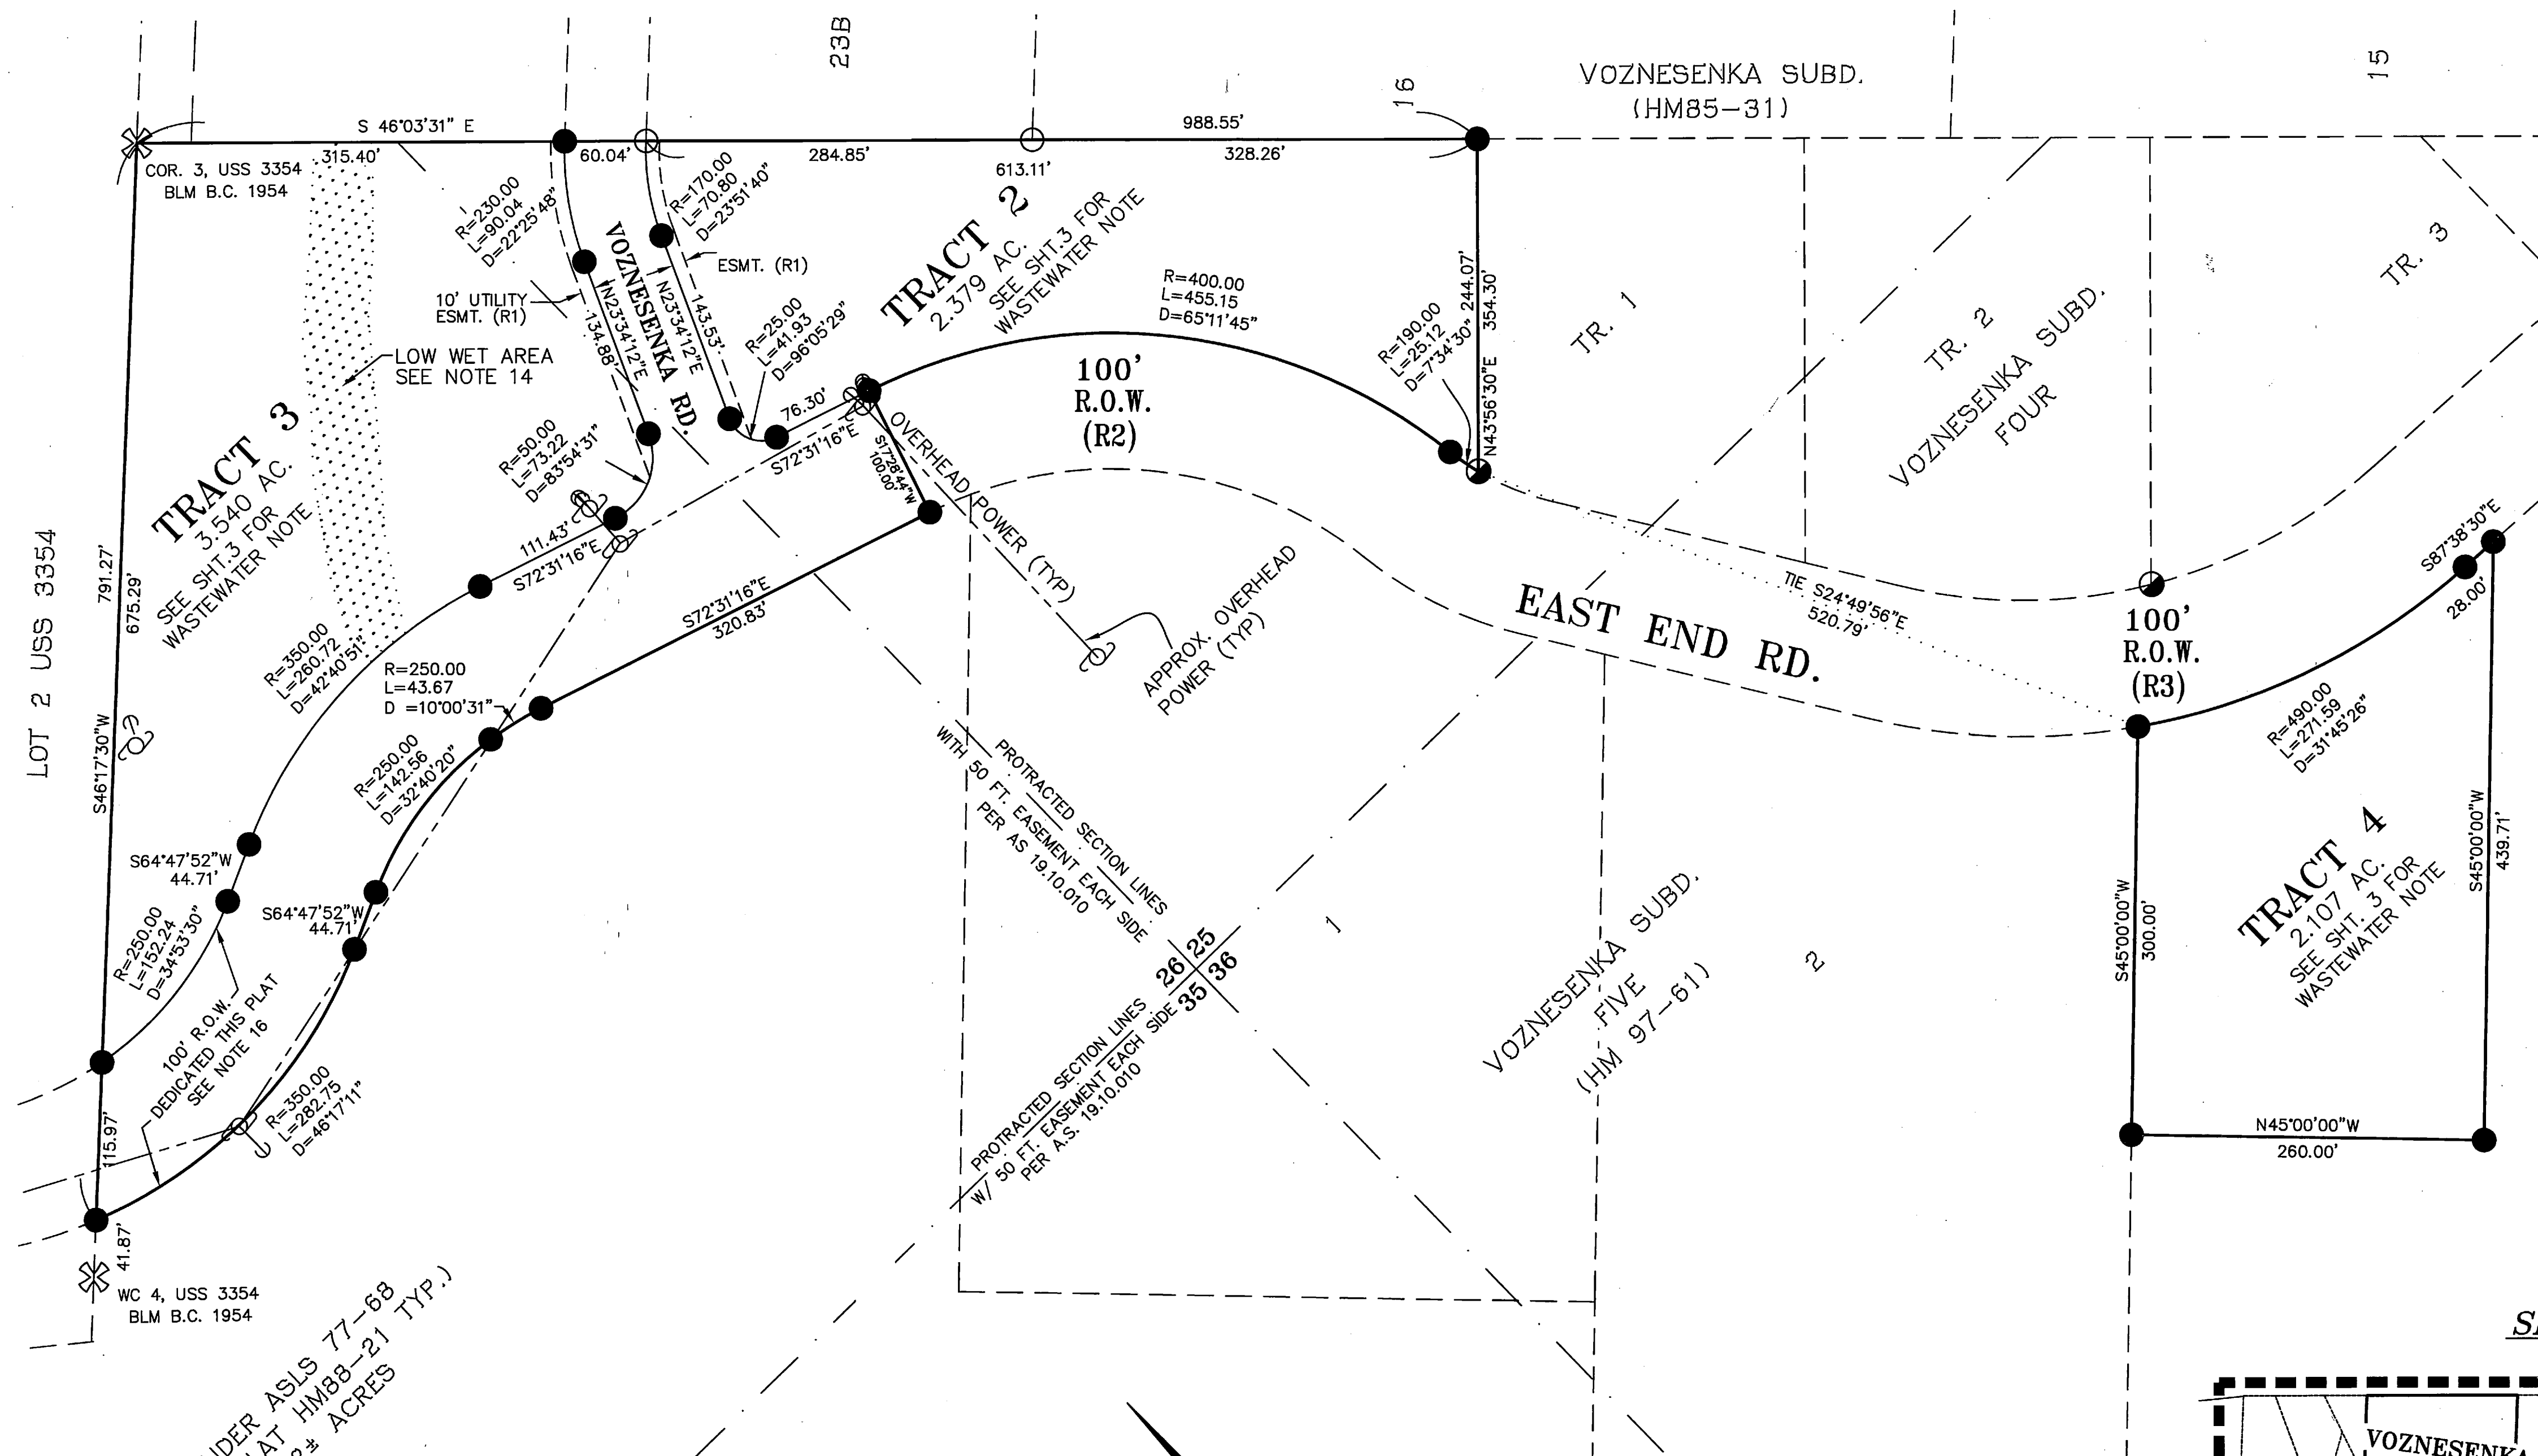

- NOTES**
1. A 20' BUILDING SETBACK SHALL EXIST ALONG ALL DEDICATED RIGHTS OF WAY UNLESS A LESSER STANDARD IS APPROVED BY RESOLUTION OF THE APPROPRIATE PLANNING COMMISSION. IN ADDITION THE FRONT 10' OF THE BUILDING SETBACK OF RIGHTS-OF-WAY DEDICATED BY THIS PLAT AND THE ENTIRE SETBACK WITHIN 5' OF SIDE LOT LINES IS A UTILITY EASEMENT. THE 20' BUILDING SETBACK SHALL ALSO SERVE AS A UTILITY EASEMENT PER HM85-31.
 2. NO PERMANENT STRUCTURE SHALL BE CONSTRUCTED OR PLACED WITHIN A UTILITY EASEMENT WHICH WOULD INTERFERE WITH THE ABILITY OF A UTILITY TO USE THE EASEMENT.
 3. NO STRUCTURES ARE PERMITTED WITHIN THE PANHANDLE PORTION OF FLAG LOT(S).
 4. SET 2" ALUMINUM CAP ON 5/8" DIAMETER REBAR AT ALL LOT CORNERS UNLESS NOTED OTHERWISE.
 5. EXISTING OVERHEAD POWERLINE(S) IS THE CENTERLINE OF A 20' WIDE ELECTRICAL DISTRIBUTION EASEMENT.
 6. THE KPB PLANNING COMMISSION GRANTED APPROVAL TO THE FOLLOWING EXCEPTION AT THEIR MEETING ON 3-25-02; KPB 20.20.190 MINIMUM LOT SIZE FOR LOT 23F-1.
 7. ROADS MUST MEET THE DESIGN AND CONSTRUCTION STANDARDS ESTABLISHED BY THE BOROUGH IN ORDER TO BE CONSIDERED FOR CERTIFICATION AND INCLUSION IN THE ROAD MAINTENANCE PROGRAM.
 8. THIS SUBDIVISION IS SERVED BY A PUBLIC WATER SYSTEM (ADEC PWSID #244955). A VILLAGE SAFE WATER SUPPLY AND DISTRIBUTION UPGRADE (PROJECT #890402) TO THE EXISTING SYSTEM IS SUBSTANTIALLY COMPLETE.
 9. THE RIGHT-OF-WAY VACATION SHOWN WITHIN LOT 22A-1 WAS APPROVED BY THE KENAI PENINSULA BOROUGH PLANNING COMMISSION AT THE MEETING OF MAY 29, 2007.
 10. ACCEPTANCE OF THE PLAT BY THE BOROUGH DOES NOT CONSTITUTE ACCEPTANCE OF ANY ENCROACHMENTS WITHIN SETBACKS, EASEMENTS, OR RIGHTS-OF WAY.
 11. EXCEPTION GRANTED FOR LOT 1-B AT THE PLAT COMMITTEE MEETING OF APRIL 23, 2007 PER KPB 20.20.190.
 12. LOT 1-B IS FOR CEMETERY PURPOSES ONLY. NO WASTEWATER SHALL BE GENERATED OR DISPOSED OF ON THIS LOT.
 13. THE BASIS OF BEARING IS S46°05'23"E 3958.69 FEET FROM CORNER 3, U.S. SURVEY 3354 TO CORNER 2, U.S. SURVEY 3354, COMPUTED AS S46°05'23"E 3958.68 FEET PER HM85-31.
- (SEE ADDITIONAL NOTES BELOW LEFT.)

CERTIFICATE OF OWNERSHIP and DEDICATION

We hereby certify that we are the owners of the following lots shown and described hereon, and that we hereby adopt this plan of subdivision, and by our free consent dedicate all public rights-of-way and grant all easements to the use shown.

PORTIONS OF ASLS 77-68


James Roy Rainwater
JAMES ROY RAINWATER (OWNER PORTION OF ASLS 77-68)

Mary Therese Rainwater
MARY THERESE RAINWATER (OWNER PORTION OF ASLS 77-68)
45425 EAST END RD.
HOMER, AK 99603-9763

NOTARY'S ACKNOWLEDGMENT

FOR: JAMES ROY RAINWATER and MARY THERESE RAINWATER
Subscribed and sworn to before me this 26th day of December, 2008.

Gary D. Nelson
Notary Public for Alaska
My Commission Expires 8.31.09

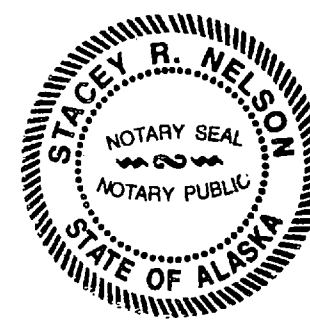


- LEGEND**
- FOUND BLM 2 1/2" BRASS CAP
 - SET 2" AL CAP ON 5/8" REBAR
 - MONUMENT OF RECORD 2" AL-CAP, HM 85-31
 - FOUND MONUMENT OF RECORD 2" AL-CAP, HM 85-31
 - FOUND MONUMENT OF RECORD 5/8" REBAR WITH 2 1/2" RED PLASTIC CAP, HM 92-9
 - VACATED LOT LINES (TYPICAL)
 - (R1) RECORD DATA PER HM85-31
 - (R2) RECORD DATA PER HM97-61
 - (R3) RECORD DATA PER HM92-09
 - POWERPOLE
 - 20' UTILITY EASEMENT PER HM85-31

NOTES CONTINUED

14. TRACT 3 MAY CONTAIN LOW WET AREAS. OWNERS SHOULD CONTACT ARMY CORPS OF ENGINEERS FOR LATEST WETLANDS DETERMINATION PRIOR TO ANY DEVELOPMENT.

15. NO ACCESS TO STATE MAINTAINED RIGHTS-OF WAY PERMITTED UNLESS APPROVED BY THE STATE OF ALASKA DEPARTMENT OF TRANSPORTATION.

16. THE EAST END ROAD RIGHT-OF-WAY DEDICATED HEREON IS APPROXIMATELY CENTERED ON THE EXISTING ROADWAY AND IS INTENDED TO HARMONIZE WITH THE 100 FEET WIDE EASEMENT AND RIGHT-OF-WAY FOR INGRESS/EGRESS AND PUBLIC ROAD CONSTRUCTION AND MAINTENANCE GRANTED TO THE STATE OF ALASKA IN BOOK 148, PAGES 771-774, HOMER RECORDING DISTRICT.

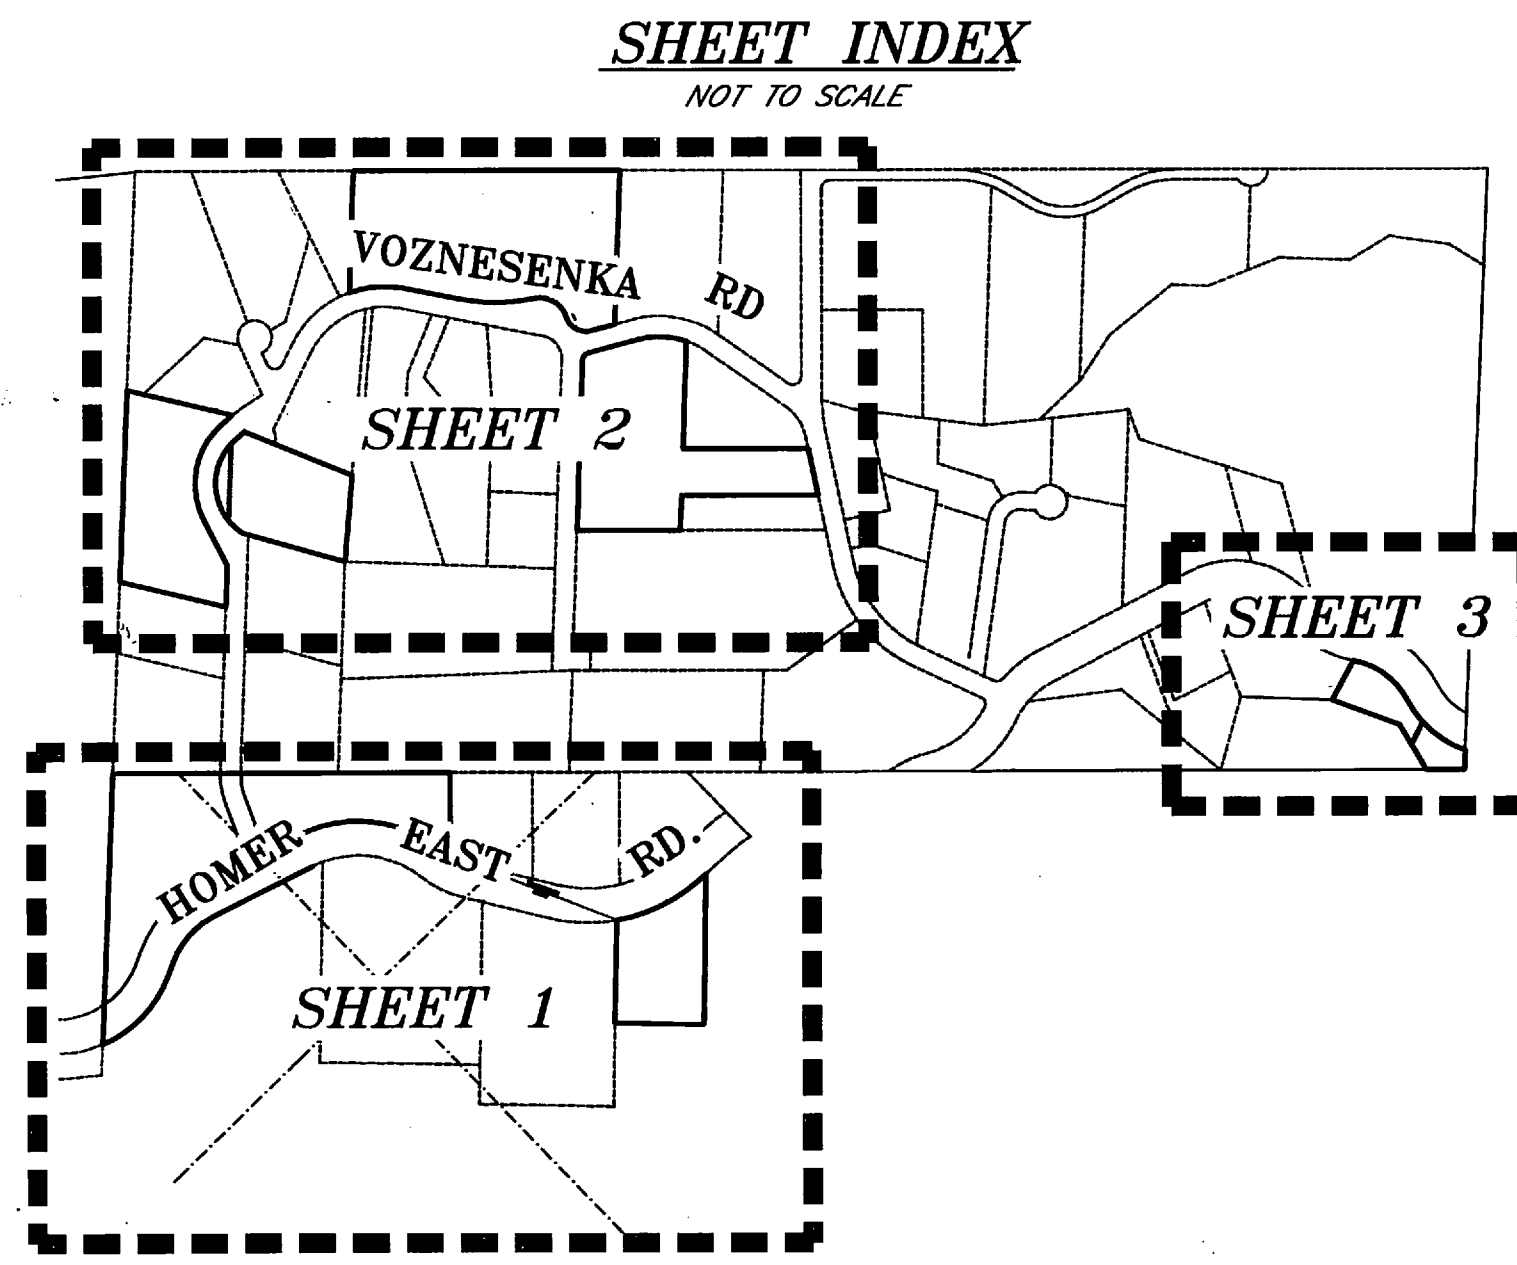


PLAT APPROVAL

This plat was approved by the Kenai Peninsula Borough Planning Commission at the meeting of April 23, 2007

KENAI PENINSULA BOROUGH

BY *Max A. Burt*
Authorized Official

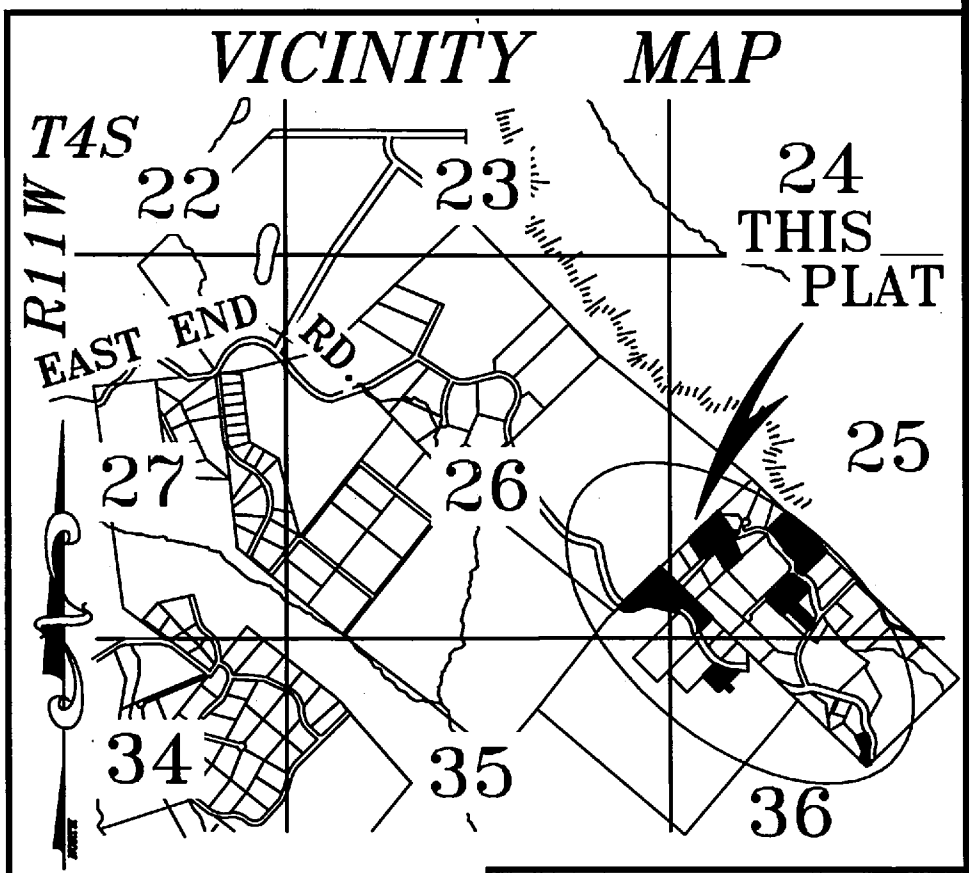

SCALE 1"= 1/2 MILE

DATE 12-11-2007

SCALE 1"=80'

DRAWING: 4003_2008

JOB No. 4003

SHEET 1 of 5



VOZNESENKA 2006

VACATING A PORTION OF VOZNESENKA ROAD R.O.W.(HM85-31) AND REPLATTING OF A PORTION OF ASLS 77-68; LOT 10B VOZNESENKA THREE (HM 91-16); LOTS 1, 13, 19, 20, 22A, 23E, 23F & 23G, VOZNESENKA SUBDIVISION (HM85-31); WITHIN LOT 1, U.S. SURVEY 3354, ALSO WITHIN THE SW1/4 OF PROTRACTED SECTION 25 THE SE1/4 OF PROTRACTED SECTION 26, THE NE1/4 OF PROTRACTED SECTION 35 AND THE NW1/4 OF PROTRACTED SECTION 36, T4S, R11W, S.M., KENAI PENINSULA BOROUGH, HOMER RECORDING DISTRICT, ALASKA CONTAINING 27.832 ACRES

ABILITY SURVEYS


GARY D. NELSON, P.L.S.
(907)235-8440
152 DEHEL AVE., HOMER, ALASKA

SHEET 1 of 5

KPB FILE No. 2002-051

ARMED 2008-94 sheet 1 of 3

NOTE: See Resolution 2021-18

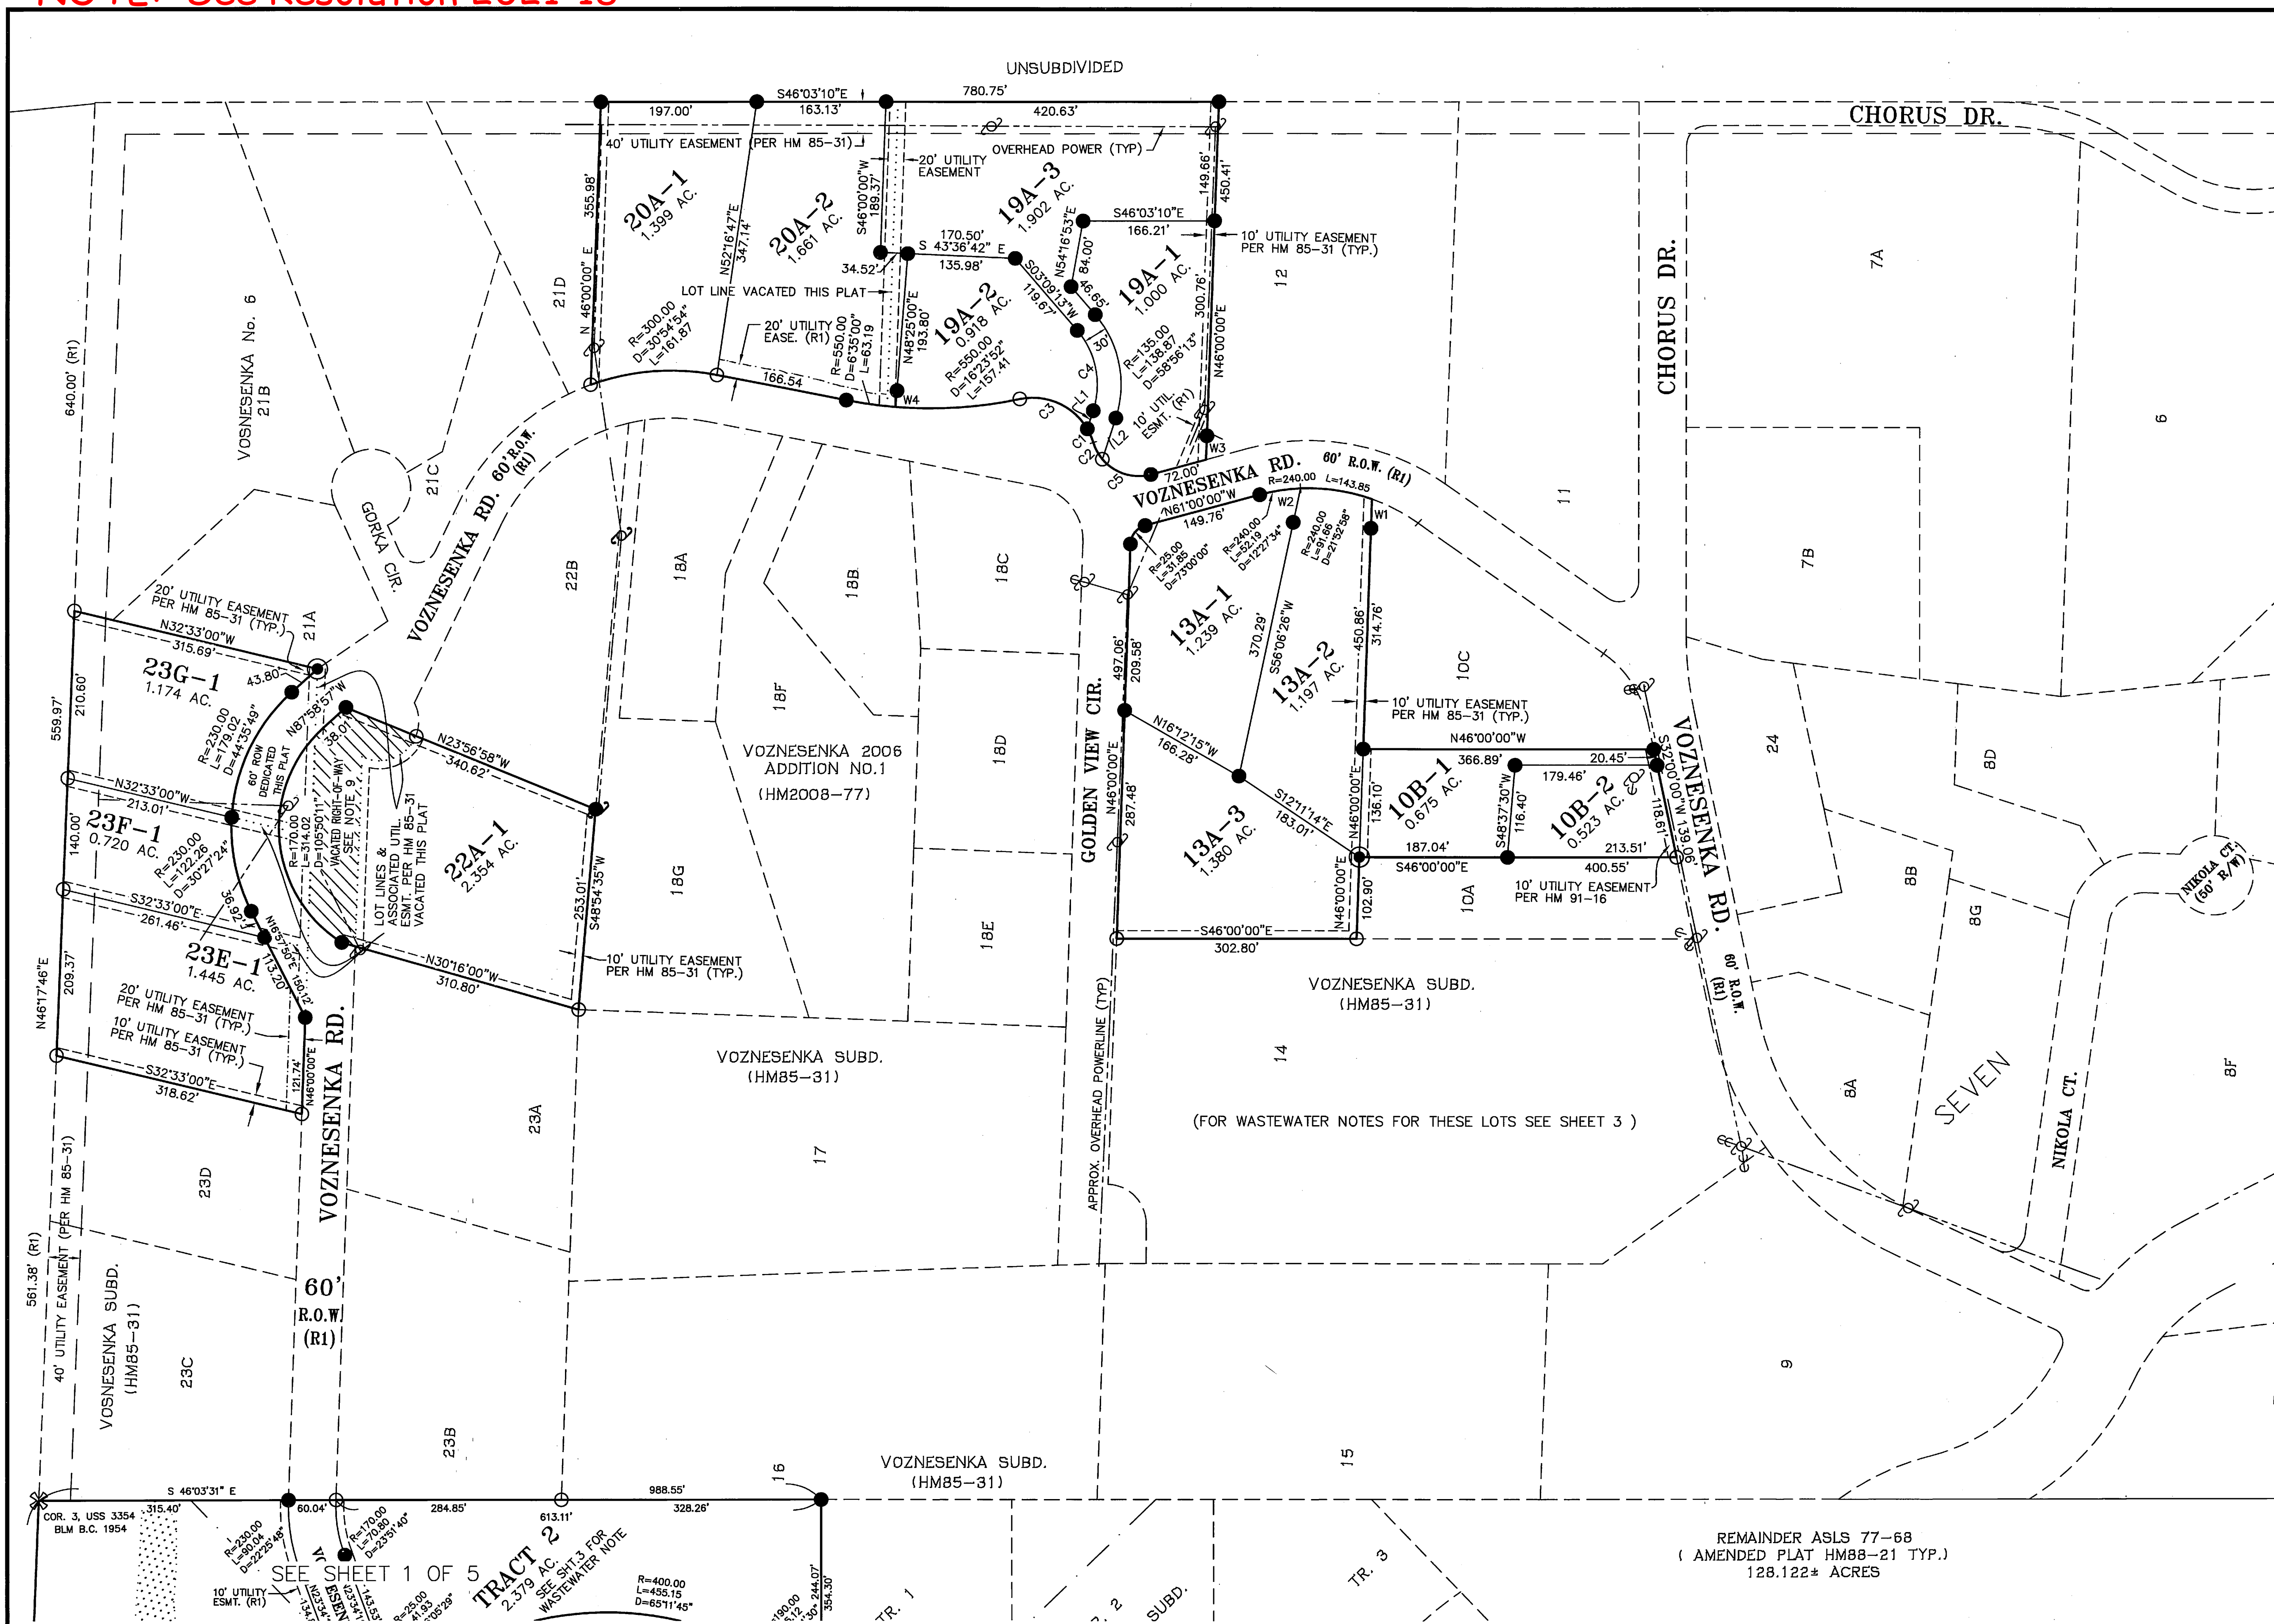


LEGEND

- FOUND BLM 2 1/2" BRASS CAP
- SET 2" AL. CAP ON 5/8" REBAR
- MONUMENT OF RECORD 2" AL-CAP, HM 85-31
- FOUND MONUMENT OF RECORD 2" AL-CAP, HM 85-31
- VACATED LOT LINES (TYPICAL)
- RECORD DATA PER HM85-31
- RECORD DATA PER HM97-61
- RECORD DATA PER HM92-09
- POWERPOLE
- 20' UTILITY EASEMENT PER HM85-31

LINE TABLE		
LINE	LENGTH	BEARING
L1	24.07	S62°05'26"W
L2	54.39	N62°05'26"E

CURVE TABLE			
CURVE	LENGTH	RADIUS	DELTA
C1	18.78	80.00	13°26'55"
C2	24.11	60.00	23°01'37"
C3	99.60	80.00	71°20'03"
C4	108.01	105.00	58°56'13"
C5	67.83	60.00	64°46'29"

WITNESS CORNER DISTANCE TABLE		
LINE	LENGTH	BEARING
W1	35.75	N46°00'00"E
W2	43.67	S56°08'26"W
W3	29.99	N46°00'00"E
W4	20.50	N48°25'00"E

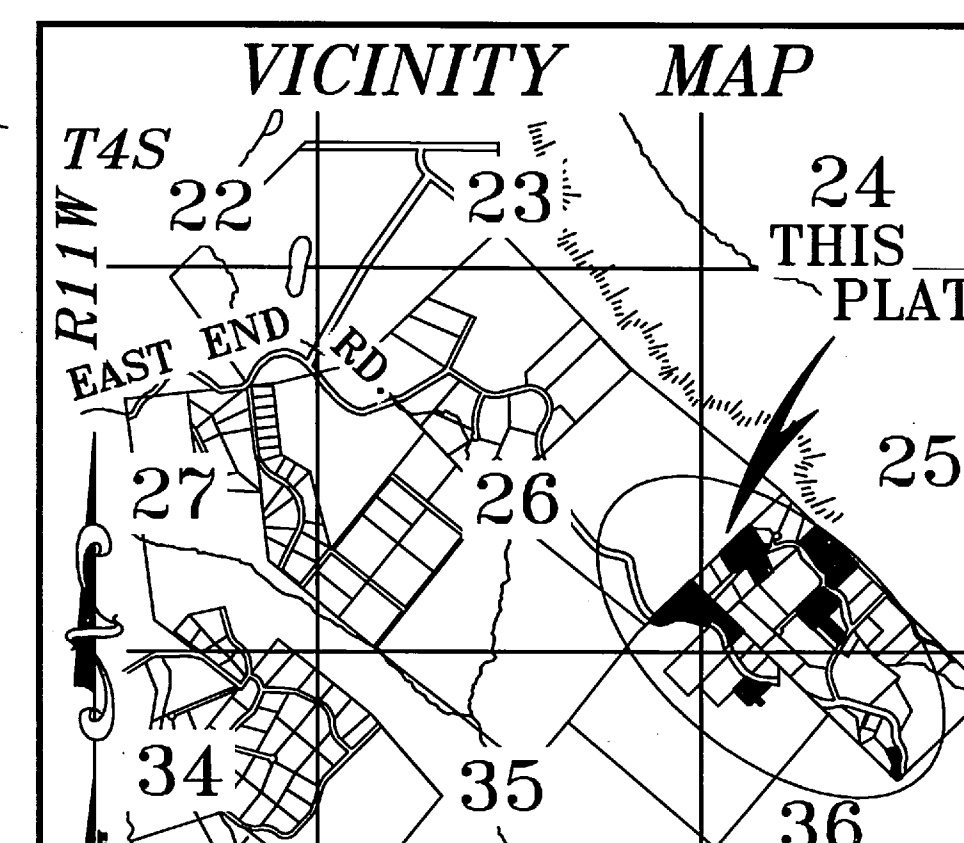

SCALE 1"= 1/2 MILE


DATE 12-11-2007

SCALE 1"=100'

DRAWING: 4003_2008

JOB No. 4003

SHEET 2 of 5

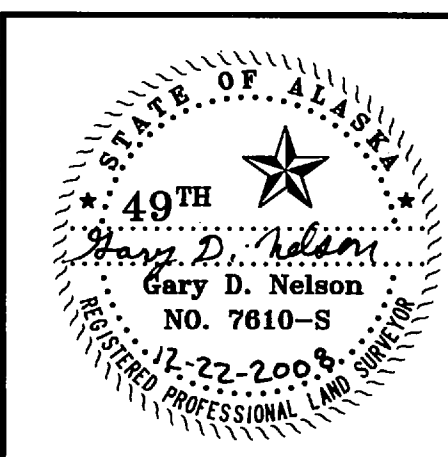

VOZNESENKA 2006

VACATING A PORTION OF VOZNESENKA ROAD R.O.W.(HM85-31) AND REPLATING OF A PORTION OF ASLS 77-68; LOT 10B VOZNESENKA THREE (HM 91-16); LOTS 1, 13, 19, 20, 22A, 23E, 23F & 23G, VOZNESENKA SUBDIVISION (HM85-31); WITHIN LOT 1, U.S. SURVEY 3354, ALSO WITHIN THE SW1/4 OF PROTRACTED SECTION 25 THE SE1/4 OF PROTRACTED SECTION 26, THE NE1/4 OF PROTRACTED SECTION 35 AND THE NW1/4 OF PROTRACTED SECTION 36, T4S, R11W, S.M., KENAI PENINSULA BOROUGH, HOMER RECORDING DISTRICT, ALASKA CONTAINING 27.832 ACRES

ABILITY SURVEYS

GARY D. NELSON, P.L.S.
(907)235-8440
152 DEHEL AVE., HOMER, ALASKA

SHEET 2 of 5

KPB FILE No. 2002-051

Sheet 2 of 5

CERTIFICATE OF OWNERSHIP and DEDICATION

We hereby certify that we are the owners of the following lots shown and described hereon, and that we hereby adopt this plan of subdivision, and by our free consent dedicate all public rights of way and grant all easements to the use shown.

LOT 1 (HM97-61)

NAZARY BASARGIN (OWNER OF LOT 1, HM97-61)

ANASTASIA BASARGIN (OWNER OF LOT 1, HM97-61)
PO BOX 3264
HOMER, AK 99603-3264

NOTARY'S ACKNOWLEDGMENT

FOR: NAZARY & ANASTASIA BASARGIN
Subscribed and sworn to before me this 10th day of March 2007

Janice G. Knight
Notary public for Alaska
My Commission Expires 12-21-10



LOT 10-B (HM91-16)

ZINAIDA E. REUTOV (OWNER OF LOT 10B, HM91-16)
P.O. BOX 529
HOMER, AK 99603

ZINAIDA E. REUTOV
P.O.A. FOR: MARFA KUZMIN (OWNER OF LOT 10B, HM91-16)
P.O. BOX 529
HOMER, AK 99603

NOTARY'S ACKNOWLEDGMENT

FOR: ZINAIDA E. REUTOV
Subscribed and sworn to before me this 21 day of December 2007

Janice G. Knight
Notary public for Alaska
My Commission Expires Dec. 25, 2010

LOT 1 (HM85-31)


IVAN P. BASARGIN (OWNER OF LOT 1, HM85-31)

D.B.
DARIA Y. BASARGIN (OWNER OF LOT 1, HM85-31)
PO BOX 183
HOMER, AK 99603

NOTARY'S ACKNOWLEDGMENT

FOR: IVAN P. & DARIA Y. BASARGIN
Subscribed and sworn to before me this 10th day of March 2007

Janice G. Knight
Notary public for Alaska
My Commission Expires 12-21-10

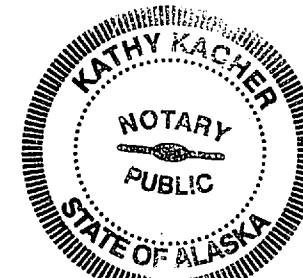

LEGEND

- ⊕ FOUND BLM 2 1/2" BRASS CAP (R1) RECORD DATA PER HM85-31
- TO SET 2" AL. CAP ON 5/8" REBAR (R2) RECORD DATA PER HM97-61
- MONUMENT OF RECORD 2" AL-CAP, HM 85-31 (R3) RECORD DATA PER HM92-09
- FOUND MONUMENT OF RECORD 2" AL-CAP, HM 85-31
- ⚡ POWERPOLE
- VACATED LOT LINES (TYPICAL)
- 20' UTILITY EASEMENT PER HM85-31


LOT 13 (HM85-31)

PETER KUZMIN (OWNER OF LOT 13, HM85-31)
PO BOX 2494
HOMER, AK 99603

NOTARY'S ACKNOWLEDGMENT

FOR: PETER KUZMIN
Subscribed and sworn to before me this 21 day of December 2007

Janice G. Knight
Notary public for Alaska
My Commission Expires 12-25-2010

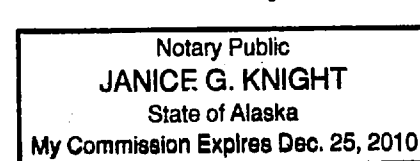

LOT 19 (HM85-31)

KSENIA BASARGIN (OWNER OF LOT 19, HM85-31)
P.O. BOX 2107
HOMER, AK 99603

NOTARY'S ACKNOWLEDGMENT

FOR: KSENIA BASARGIN
Subscribed and sworn to before me this 12th day of March 2007

Janice G. Knight
Notary public for Alaska
My Commission Expires 12-21-10



LOT 22A (HM85-31)

ANDREI MARTUSHEV (OWNER OF LOT 22A, HM85-31)
PO BOX 805
HOMER, AK 99603

NOTARY'S ACKNOWLEDGMENT

FOR: ANDREI MARTUSHEV
Subscribed and sworn to before me this 28th day of December 2007



Janice G. Knight
Notary public for Alaska
My Commission Expires 7-18-11

MARY MARTUSHEV (OWNER OF LOT 22A, HM85-31)
PO BOX 805
HOMER, AK 99603

NOTARY'S ACKNOWLEDGMENT

FOR: MARY MARTUSHEV
Subscribed and sworn to before me this 28th day of December 2007

Janice G. Knight
Notary public for Alaska
My Commission Expires 7-18-11

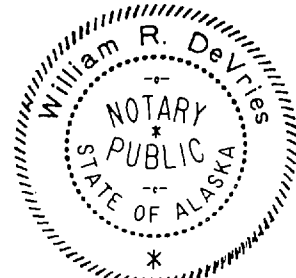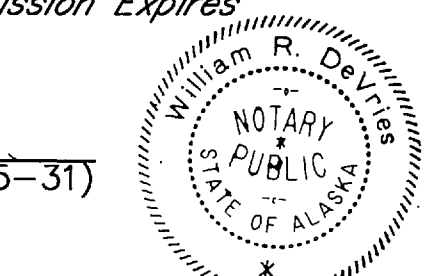


LOT 23E (HM85-31)

ZAHAR ZACK REUTOV (OWNER OF LOT 23E, HM85-31)
PO BOX 3005
HOMER, AK 99603

NOTARY'S ACKNOWLEDGMENT

FOR: ZAHAR ZACK REUTOV
Subscribed and sworn to before me this 20th day of December 2007

Janice G. Knight
Notary public for Alaska
My Commission Expires 7-18-11

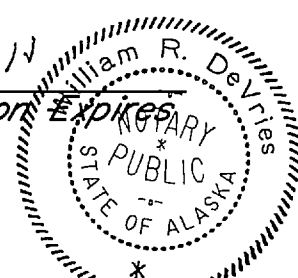


EVGENIA KULIKOV (OWNER OF LOT 23E, HM85-31)
PO BOX 3005
HOMER, AK 99603

NOTARY'S ACKNOWLEDGMENT

FOR: EVGENIA KULIKOV
Subscribed and sworn to before me this 10th day of March 2007

Janice G. Knight
Notary public for Alaska
My Commission Expires 12-21-10

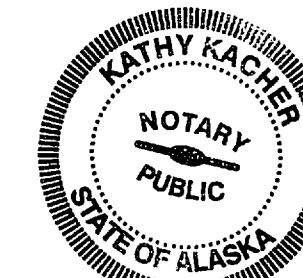

LOT 23G (HM85-31)

BILL V. AFONIN (OWNER OF LOT 23G, HM85-31)
PO BOX 1472
HOMER, AK 99603

NOTARY'S ACKNOWLEDGMENT

FOR: BILL V. AFONIN
Subscribed and sworn to before me this 21 day of December 2007



Janice G. Knight
Notary public for Alaska
My Commission Expires 12-25-2010

VERAAAFONIN (OWNER OF LOT 23G, HM85-31)
PO BOX 1472
HOMER, AK 99603

NOTARY'S ACKNOWLEDGMENT

FOR: VERAAAFONIN
Subscribed and sworn to before me this 21 day of December 2007

Janice G. Knight
Notary public for Alaska
My Commission Expires 12-25-2010

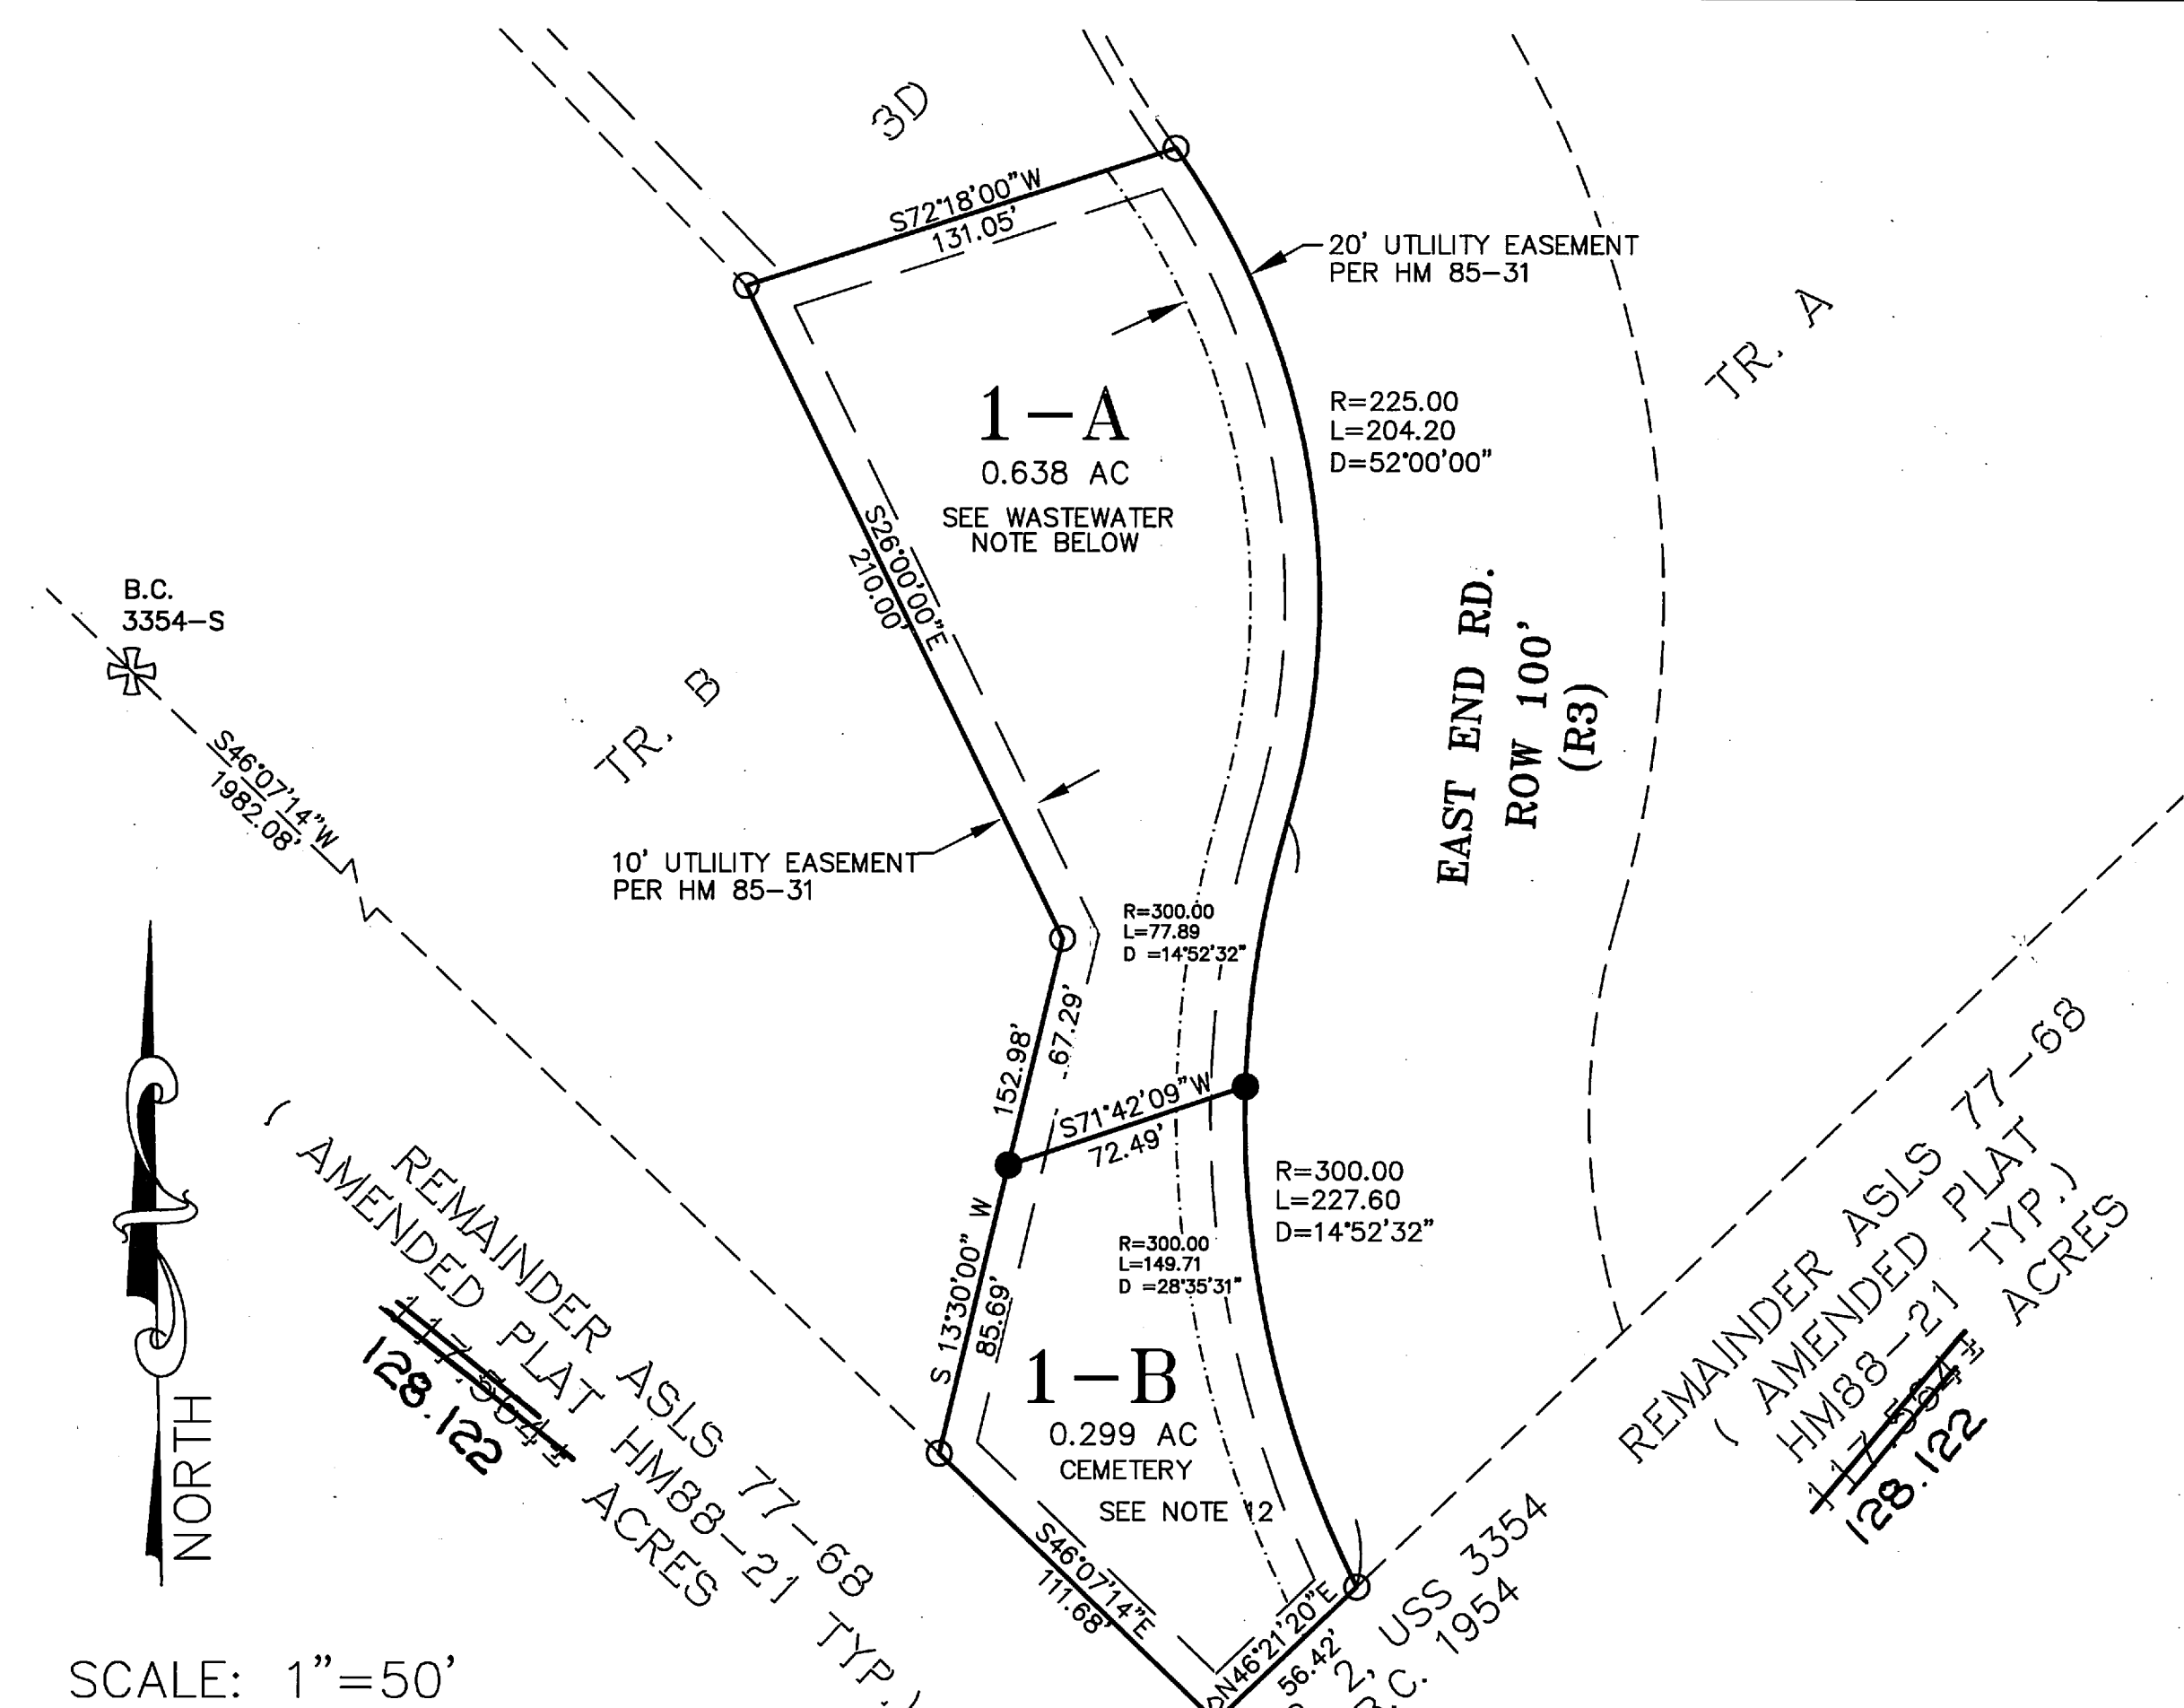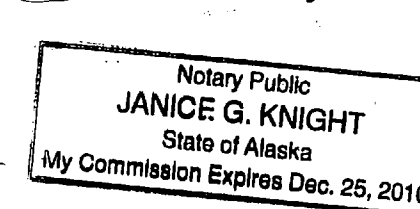

WASTEWATER NOTES

TRACT 5 AND TRACT 1-A ARE AT LEAST 200,000 SQUARE FEET, OR NOMINAL 5 ACRES IN SIZE AND CONDITIONS MAY NOT BE SUITABLE FOR ONSITE WASTEWATER TREATMENT AND DISPOSAL. ANY WASTEWATER TREATMENT OR DISPOSAL SYSTEM MUST MEET THE REGULATORY REQUIREMENTS OF THE ALASKA DEPARTMENT OF ENVIRONMENTAL CONSERVATION.

FOR TRACTS 2, 3, AND LOTS 19A-1, 19A-2, 19A-3, 20A-1, 20A-2, 1-A, SOIL CONDITIONS, WATER TABLE LEVELS, AND SOIL SLOPES IN THIS SUBDIVISION HAVE BEEN FOUND SUITABLE FOR CONVENTIONAL ONSITE WASTEWATER TREATMENT AND DISPOSAL SYSTEMS SERVING SINGLE-FAMILY OR DUPLEX RESIDENCES AND MEETING THE REGULATORY REQUIREMENTS OF THE KENAI PENINSULA BOROUGH. ANY OTHER TYPE OF ONSITE WASTEWATER TREATMENT AND DISPOSAL SYSTEM MUST BE DESIGNED BY A PROFESSIONAL ENGINEER, REGISTERED TO PRACTICE IN ALASKA, AND THE DESIGN MUST BE APPROVED BY THE ALASKA DEPARTMENT OF ENVIRONMENTAL CONSERVATION.


FOR TRACT 4 AND LOTS 10B-1, 10B-2, 13A-1, 13A-2, 13A-3, 23G-1, 23F-1, 23E-1 SOIL CONDITIONS IN THIS SUBDIVISION HAVE BEEN FOUND UNSUITABLE FOR CONVENTIONAL ONSITE WASTEWATER TREATMENT AND DISPOSAL SYSTEMS. PLANS FOR A TYPICAL ALTERNATE WASTEWATER DISPOSAL SYSTEM FOR USE ON LOTS IN THIS SUBDIVISION ARE INCLUDED IN THE ENGINEER'S SUBDIVISION AND SOILS REPORT AND ARE AVAILABLE FROM THE KENAI PENINSULA BOROUGH. ALL ALTERNATE ONSITE WASTEWATER TREATMENT AND DISPOSAL SYSTEMS MUST BE DESIGNED BY A PROFESSIONAL ENGINEER REGISTERED TO PRACTICE IN ALASKA, AND THE DESIGN MUST BE APPROVED BY THE ALASKA DEPARTMENT OF ENVIRONMENTAL CONSERVATION PRIOR TO CONSTRUCTION.

NO WASTEWATER WILL BE GENERATED OR DISPOSED OF ON LOT 1-B. CONDITIONS MAY NOT BE SUITABLE FOR FOR ONSITE WASTEWATER TREATMENT AND DISPOSAL SYSTEMS. ANY ONSITE WASTEWATER TREATMENT AND DISPOSAL SYSTEM MUST MEET THE WASTEWATER AND DISPOSAL REQUIREMENTS OF KPB CHAPTER 20.14 AND REGULATORY REQUIREMENTS OF THE ALASKA DEPARTMENT OF ENVIRONMENTAL CONSERVATION.


W. T. Tamm
ENGINEER
3380-E
12 MAR 08
DATE
12/29/2007
Time
2:07 PM
Requested by
Address

SHEET 3 of 5

KPB FILE No. 2002-051
2008-093

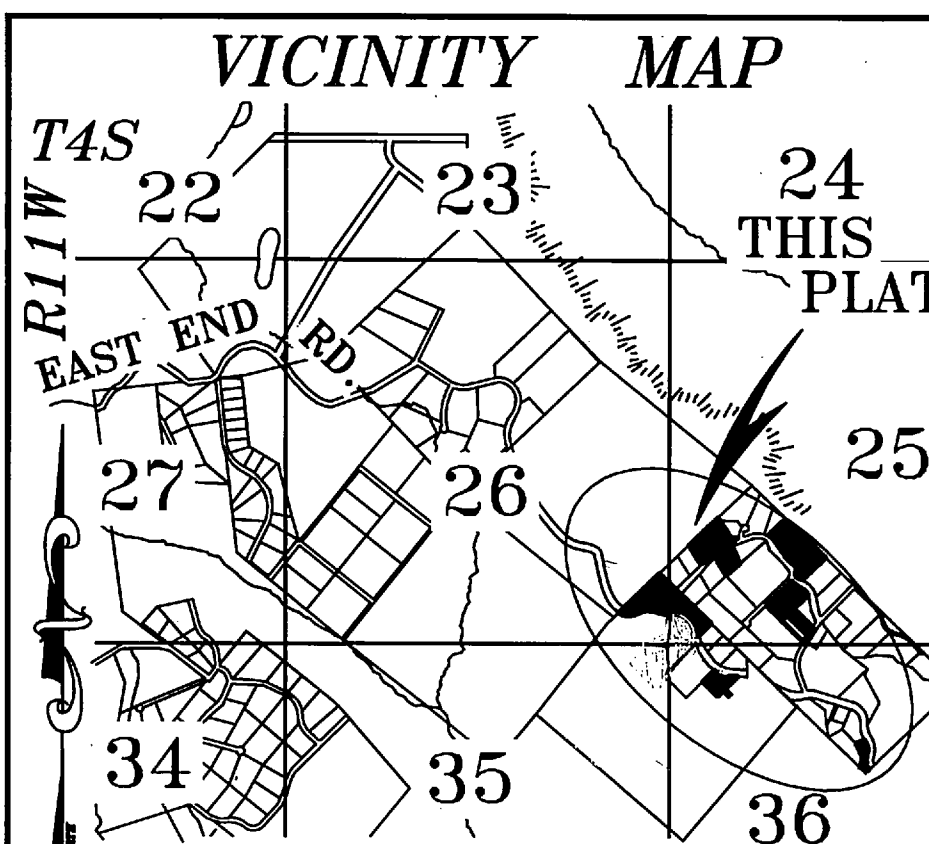

DATE 12-11-2007
SCALE 1"=50'
DRAWING: 4003_2006
JOB No. 4003
SHEET 3 of 5

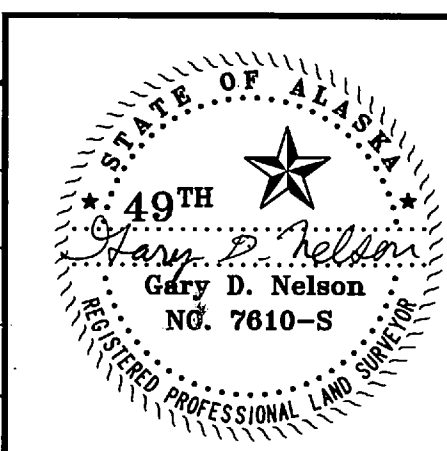

VOZNESENKA 2006
VACATING A PORTION OF VOZNESENKA ROAD R.O.W.(HM85-31) AND REPLATTING OF A PORTION OF ASLS 77-68; LOT 1, VOZNESENKA FIVE (HM97-01); LOT 10B VOZNESENKA THREE (HM 91-16); LOTS 1, 13, 19, 20, 22A, 23E, 23F & 23G, VOZNESENKA SUBDIVISION (HM85-31); WITHIN LOT 1, U.S. SURVEY 3354, ALSO WITHIN THE SW1/4 OF PROTRACTED SECTION 25 THE SE1/4 OF PROTRACTED SECTION 26, THE NE1/4 OF PROTRACTED SECTION 35 AND THE NW1/4 OF PROTRACTED SECTION 36, T4S, R11W, S.M., KENAI PENINSULA BOROUGH, HOMER RECORDING DISTRICT, ALASKA CONTAINING 128.122 ACRES


ABILITY SURVEYS
GARY D. NELSON, P.L.S.
(907)235-8440
152 DEHEL AVE., HOMER, ALASKA

Alaska 2008-74 - Sheet 3 of 5

Homer 2008-94

CERTIFICATE OF OWNERSHIP and DEDICATION

NOTE: See Resolution 2021
We hereby certify that we are the owners of the following lots shown and described hereon, and that we hereby adopt this plan of subdivision, and by our free consent dedicate all public rights-of-way and grant all easements to the use shown.

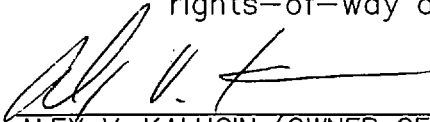

ALEX V. KALUGIN (OWNER OF LOT 20, HM85-31)

PO BOX 385
NINE MILE FALLS, WA 99028-0385


NOTARY'S ACKNOWLEDGMENT


FOR: ALEX V. KALUGIN

Subscribed and sworn to before me this 4 day
of March 2008


Notary public for Washington

11-18-09
My Commission Expires

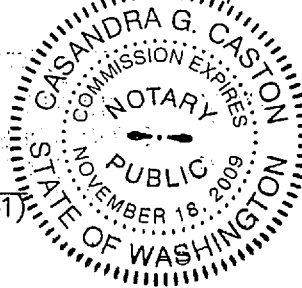

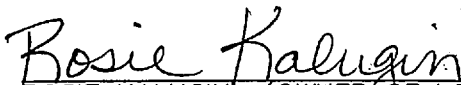


ROSIE KALUGIN (OWNER OF LOT 20, HM85-31)

PO BOX 385
NINE MILE FALLS, WA 99028-0385


NOTARY'S ACKNOWLEDGMENT

FOR: ROSIE KALUGIN

Subscribed and sworn to before me this 4 day
of March 2008

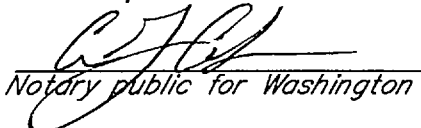
Notary public for Washington

11-18-09
My Commission Expires

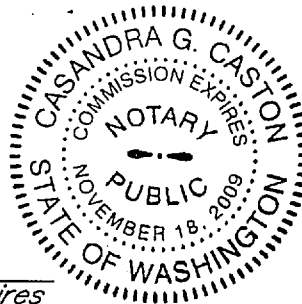

VOZNESENKA 2006

VACATING A PORTION OF VOZNESENKA ROAD R.O.W.(HM85-31) AND REPLATTING OF A PORTION OF ASLS 77-68; ~~LOT 1, VOZNESENKA FIVE (HM97-61)~~; LOT 10B VOZNESENKA THREE (HM 91-16); LOTS 1, 13, 19, 20, 22A, 23E, 23F & 23G, VOZNESENKA SUBDIVISION (HM85-31); WITHIN LOT 1, U.S. SURVEY 3354, ALSO WITHIN THE SW1/4 OF PROTRACTED SECTION 25 THE SE1/4 OF PROTRACTED SECTION 26, THE NE1/4 OF PROTRACTED SECTION 35 AND THE NW1/4 OF PROTRACTED SECTION 36, T4S, R11W, S.M.,
KENAI PENINSULA BOROUGH,
HOMER RECORDING DISTRICT, ALASKA
CONTAINING ~~46.219 ACRES~~ 27.832 ACRES

PREPARED BY

ABILITY SURVEYS

GARY D. NELSON, P.L.S.

(907)235-8440

152 DEHEL AVE., HOMER, ALASKA

DATE

12/11/2007

JOB No.

4003

DRAWING:

4003_2006

SHEET 4 of 5

Homer 2008-94

NOTE: See Resolution 2021


CERTIFICATE OF OWNERSHIP AND DEDICATION
I hereby certify that I am the owner of the following lots shown and described hereon, and that I hereby adopt this plan of subdivision, and by my free consent dedicate all public rights-of-way and grant all easements to the use shown.

Gorodor Reutov
FORODOR REUTOV (OWNER OF LOT 23F, HM85-31)
3625 CARLETON AVE.
APT. C
ANCHORAGE, AK 99517

NOTARY'S ACKNOWLEDGMENT

FOR: FORODOR REUTOV
Subscribed and sworn to before me this 8th day
of February 2008

Mary M. Cooper
Notary public for Alaska
My Commission Expires 12/08/2009

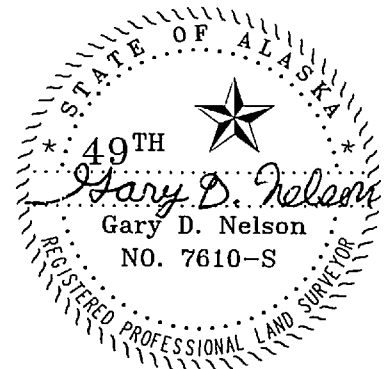

VOZNESENKA 2006

VACATING A PORTION OF VOZNESENKA ROAD R.O.W.(HM85-31) AND REPLATTING OF A PORTION OF ASLS 77-68; ~~LOT 1, VOZNESENKA FIVE (HM97-61);~~ LOT 10B VOZNESENKA THREE (HM 91-16); LOTS 1, 13, 19, 20, 22A, 23E, 23F & 23G, VOZNESENKA SUBDIVISION (HM85-31); WITHIN LOT 1, U.S. SURVEY 3354, ALSO WITHIN THE SW1/4 OF PROTRACTED SECTION 25 THE SE1/4 OF PROTRACTED SECTION 26, THE NE1/4 OF PROTRACTED SECTION 35 AND THE NW1/4 OF PROTRACTED SECTION 36, T4S, R11W, S.M., KENAI PENINSULA BOROUGH, HOMER RECORDING DISTRICT, ALASKA CONTAINING ~~46.219 ACRES~~ 27.832 ACRES

PREPARED BY
ABILITY SURVEYS
GARY D. NELSON, P.L.S.
(907)235-8440
152 DEHEL AVE., HOMER, ALASKA

DATE	12/11/2007
JOB No.	4003
DRAWING:	4003_2006

SHEET 5 of 5