





EASTWOOD COURT

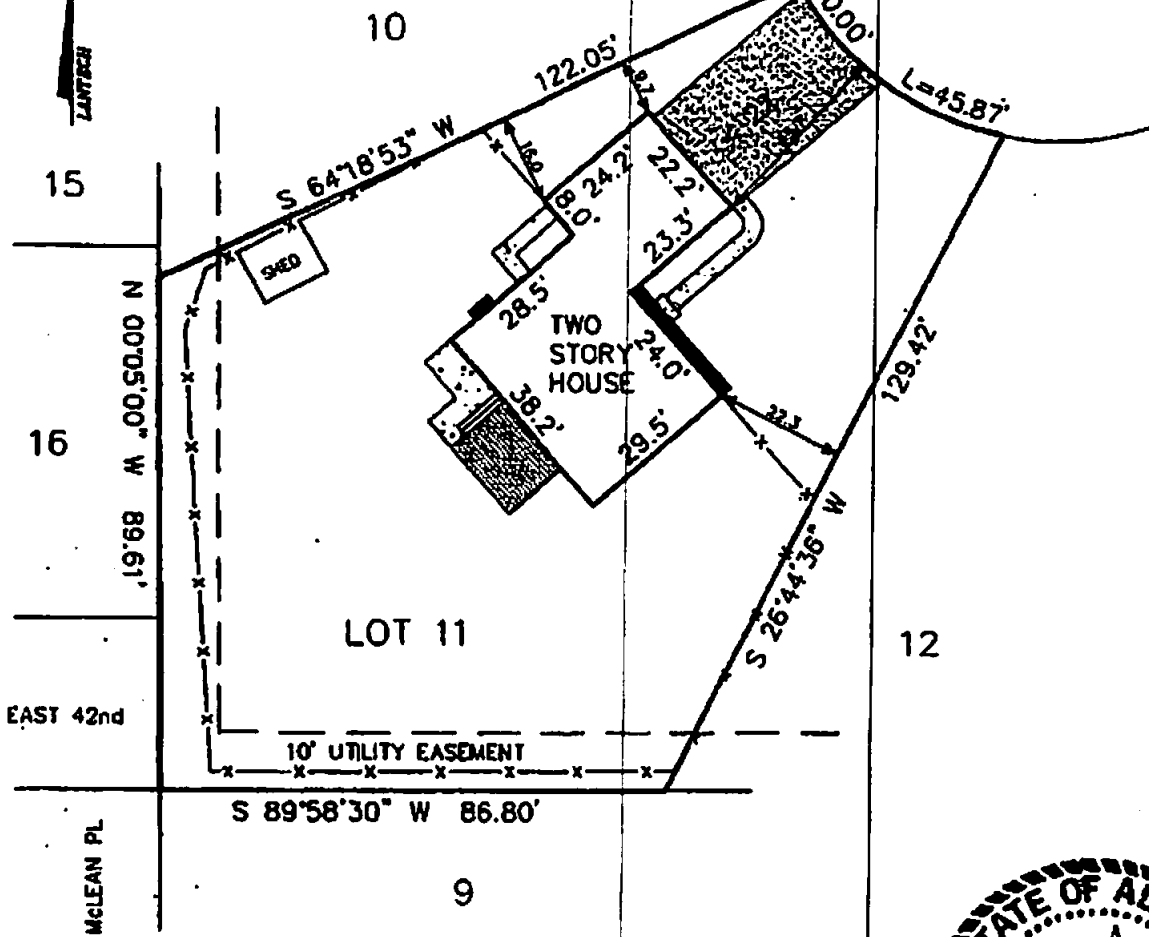

LEGEND:

3/8" REBAR SET	⊙	FWD	⊙
1.5" PLASTIC MONUMENT SET	⊙		
FENCE	-x-x-		
OVERHANG	[Pattern]		
WOOD DECK	[Pattern]		
CONCRETE	[Pattern]		
ASPHALT	[Pattern]		
EASEMENT LINE	-x-x-		
SEPTIC STANDPIPES	⊙		
WATER WELL	⊙		
ELEV (DATUM ASSUMED)	⊙		

ORDERED BY:
CAROLYN ABNEY
 with FORTUNE PROPERTIES

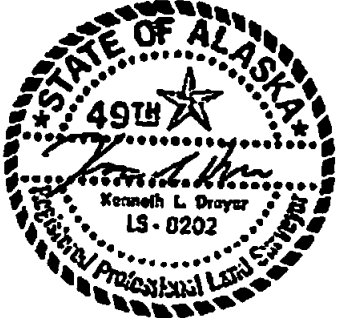

Lantech

LEGAL DESCRIPTION: AS-BUILT OF:
LOT 11

LAND & CONSTRUCTION SURVEYORS-PLANNERS-ENGINEERS
 440 WEST BENSON BLVD. # 103
 ANCHORAGE, ALASKA 99503 562-5291 (F)581-8828

EASTWOOD PARK ESTATES

WORK ORDER NUMBER: 92-L-025A

DATE: JAN 20, 1992
 SCALE: 1"=30'
 DRAWN BY: DMD.
 CHECKED BY: L.
 JOB NUMBER: 1738

EXCLUSION NOTES: It is the owners' responsibility to determine the existence of any easements, covenants, or restrictions which do not appear on the recorded subdivision plot.

Under no circumstances should any data herein be used for construction or for establishing boundary or fence lines.