



Broadway Ave.

50' ROW

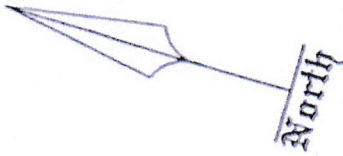

Lot 2

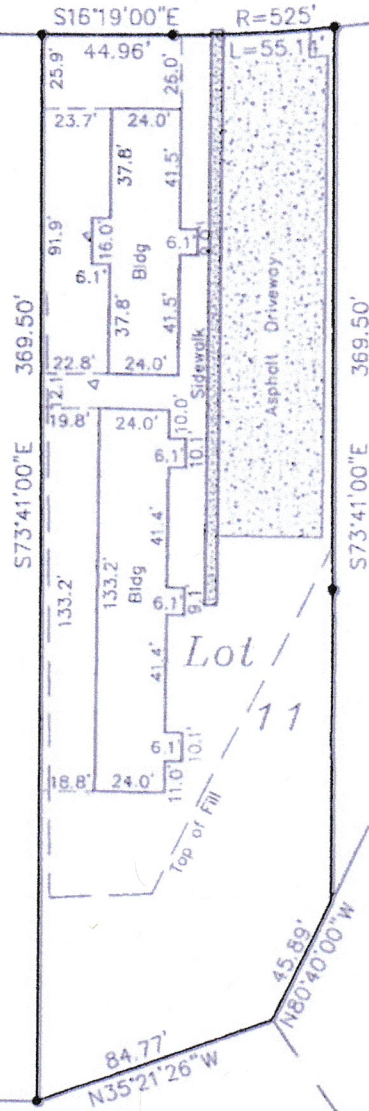

Lot 10

Lot 5

Lot 4

Tract A

ASBUILT CERTIFICATION

LEGEND

- Found Rebar
- △ Cleanout

I hereby certify that I have surveyed the following described property:

Lot 11

Riverside Subd.

and that no encroachments exist except as indicated hereon.

Exclusion Note:

It is the responsibility of the Owner to determine the existence of any easements, covenants, or restrictions which do not appear on the recorded subdivision plat. Under no circumstances should any data hereon be used for construction or for establishing boundary or fence lines.

Aleutian Islands
Recording District

Plot: 78-7

Date: 9-12-97

Scale: 1"=40'

Drawn: JFS

Job: 97072

Book: 97004

Disc:

Wince-Corthell-Bryson

Box 1041
Kenai, AK 99611
(907) 283-4672

