


894 Caribou

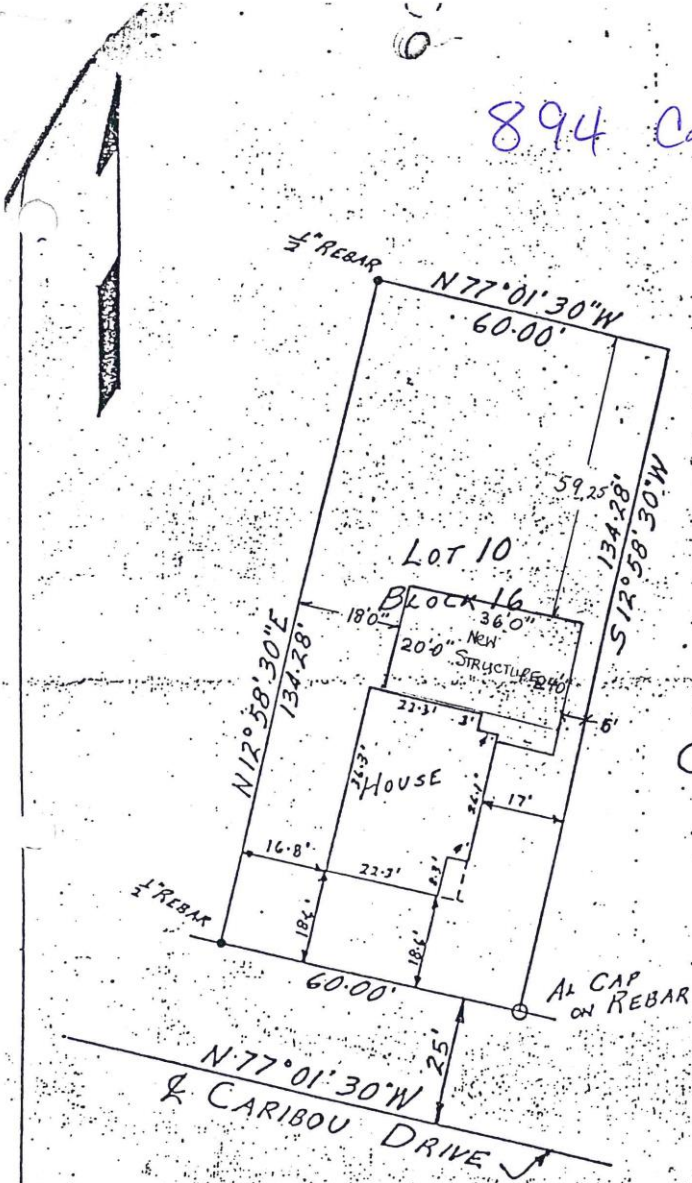

U.S.S. 4498
CITY OF KOTZEBUE,
ALASKA

As-built Certificate:

I hereby certify that I have surveyed the following described property: H. L. Saylor
and that no encroachments exist except as indicated.

Exclusion Note:

It is the responsibility of the owner to determine the existence of any easements, covenants, or re-

