


NOTES:

1. SEE PLAT NOTES IF APPLICABLE
2. MAT SU BOROUGH SIDE SETBACKS ARE 10.0 FT.
3. OLD WIRE FENCE ON WEST LINE & SOUTH LINE NOT SHOWN AT TIME OF SURVEY.

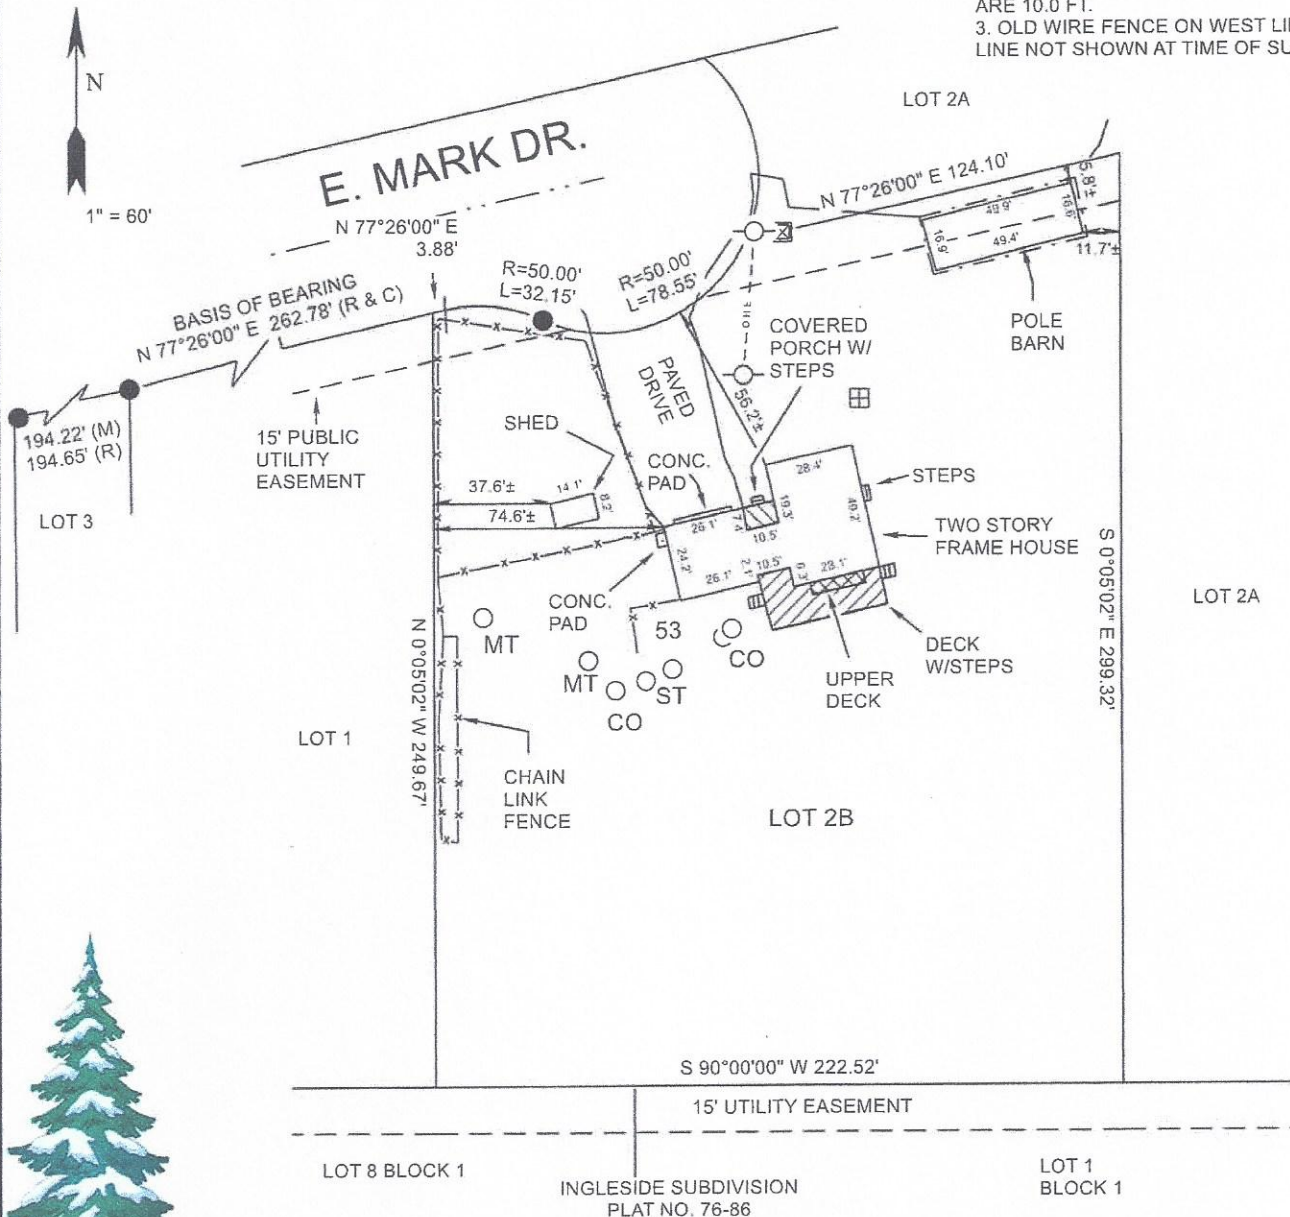

**DENALI NORTH**

1190 N. Helen Ln. Wasilla, Ak 99654  
Phone (907)376-9535

I HEREBY CERTIFY THAT I HAVE SURVEYED THE FOLLOWING DESCRIBED PROPERTY: LOT 2B A RESUB OF GREEN RIDGE SUBD. PLAT NO. 79-489

PALMER RECORDING DISTRICT, AND THERE ARE NO ENCROACHMENTS VISIBLE AT THE TIME OF THIS SURVEY, EXCEPT AS INDICATED.  
DATED THIS 5TH DAY OF AUG. 20 26 AT WASILLA, ALASKA.  
IT IS THE RESPONSIBILITY OF THE OWNERS OR BUILDERS TO DETERMINE THE EXISTENCE OF ANY EASEMENTS, COVENANTS OR RESTRICTIONS WHICH DO NOT APPEAR ON THE RECORDED SUBDIVISION PLAT. UNDER NO CIRCUMSTANCES SHOULD ANY DATA HEREON BE USED FOR CONSTRUCTION OR ESTABLISHING BOUNDARY OR FENCE LINES. THIS IS NOT A LOT CORNER SURVEY.

|                 |           |                   |                  |
|-----------------|-----------|-------------------|------------------|
| JOB NO.         | 26-143    | FIELD BOOK/PG(S). | 321/74           |
| SCALE: 1" = 60' | PLOT PLAN | ASBUILT X         | DRAWN HW CKD. WW |



LEGEND

- POWER POLE W/ANCHOR
- ⊠ MTA PEDESTAL
- ⊞ WELL
- FOUND 1/2" REBAR

©2026