

1 VICINITY MAP
SCALE: 1" = 1/2 MILE

LEGEND

	TEST HOLE
	SEWER
	KPB GIS GROUND ELEVATION CONTOURS, 5' INTERVAL





- NOTES:**
1. IMPROVEMENTS NOT SURVEYED BUT SHOWN APPROXIMATELY BASED ON AERIAL IMAGERY AND SITE MEASUREMENTS AND OBSERVATION.
 2. 1500-GAL ORENCO ADVANTEX FAP 3.0 WITH CONCRETE BALLAST, PER ORENCO ADVANTEX INSTALLATION MANUAL.
 3. ORENCO DISCHARGE PUMP BASIN WITH UV DISINFECTION, ORENCO PF2005 PUMP, & CONCRETE BALLAST, PER ORENCO ADVANTEX INSTALLATION MANUAL.

2 SITE PLAN
1 SCALE: 1" = 40'

RECORD DRAWING
This record drawing was prepared based on our intermittent construction observation, and contractor provided information, and is provided solely to show compliance with 18 AAC 72. To the best of our knowledge, this drawing represents the work as constructed. Any use of this drawing after the date shall be for information and record purposes only, and not for construction.
Skyline Engineering Services, LLC
Date 21 Sep '25



REVISIONS
 SKYLINE ENGINEERING SERVICES, LLC www.skylineengineeringak.com skyline.engineeringak@gmail.com (907) 260-4117
WASTEWATER SYSTEM SITE PLAN DELORES MCFARLAND SUB STEVENS ADDN LOT 2A Seward, Alaska
DATE: AUG 2025 DRAWN: HSW CHECKED: CS FILE NAME: 11X17RD PROJ #: 24096
1
9 of 2

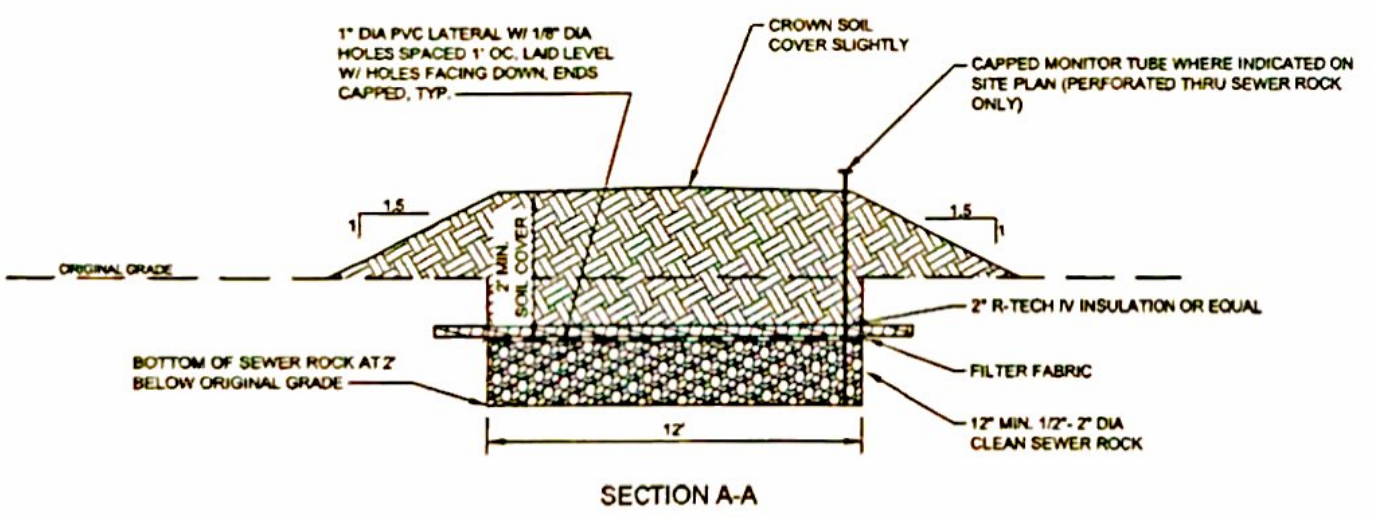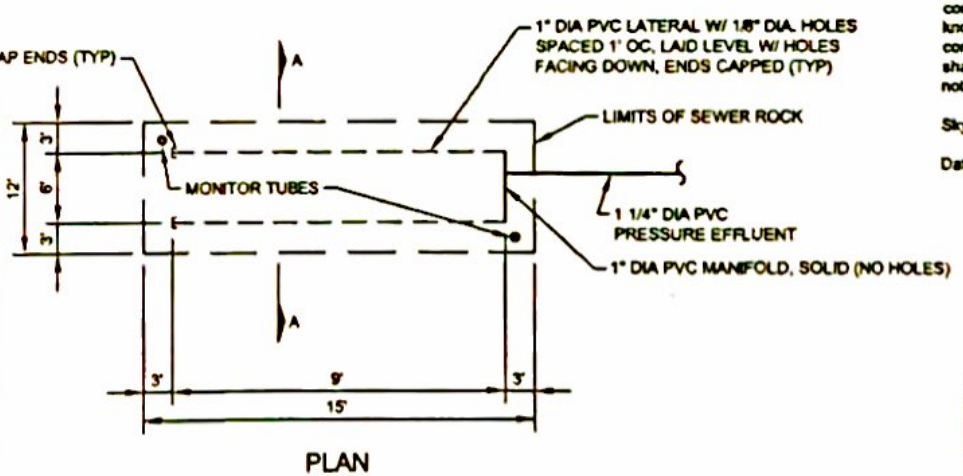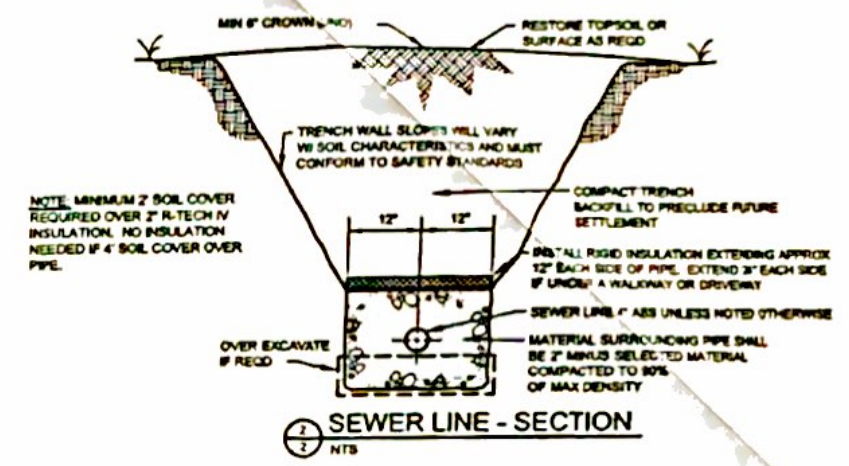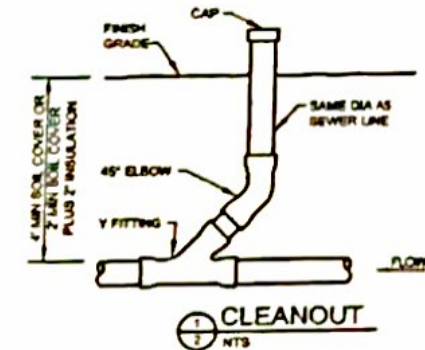

1 PRESSURIZED BED SAS NTS

RECORD DRAWING
 This record drawing was prepared based on our intermittent construction observation, and contractor provided information, and is provided solely to show compliance with 15 AAC 72. To the best of our knowledge, this drawing represents the work as constructed. Any use of this drawing after this date shall be for information and record purposes only, and not for construction.
 Skyline Engineering Services, LLC
 Date *21 Sep '25*



--

SKYLINE
 ENGINEERING SERVICES, LLC
 www.skylineengineeringak.com
 skyline_engineeringak@gmail.com
 (907) 260-4117

WASTEWATER SYSTEM DETAILS
 DELORES MCFARLAND SUB STEVENS ADDN LOT 2A
 Seward, Alaska

DATE	AUG 2025
DRAWN	HSW
CHECKED	CS
FILE NAME	11X17RD
PROJ #	24098

SHEET
2
 OF 2