


Tract P-12

S89°05'12"E 81.09

Wood fence (typ)

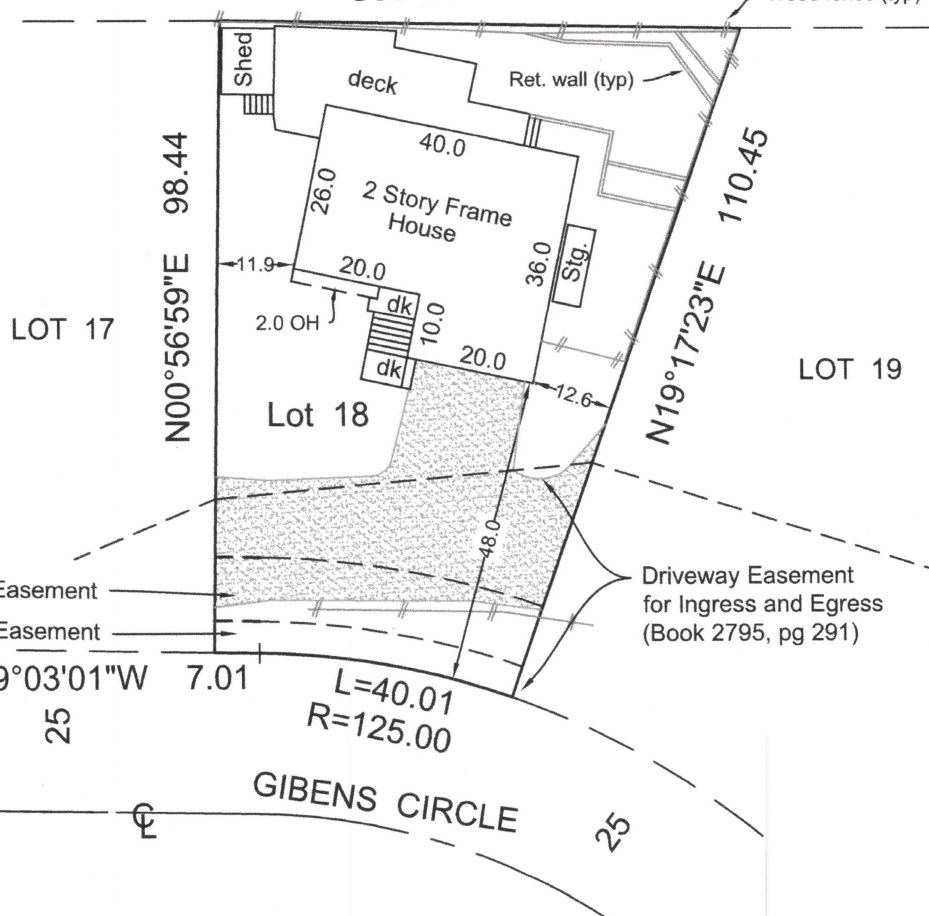

RECERTIFIED 3-01-23

AS-BUILT

NO CORNERS SET THIS DATE

I hereby certify that I have performed a Mortgagee's inspection in accordance with ASPLS Standards of the following described property: LOT 18, BLOCK 4,

PARKVIEW TERRACE EAST SUBDIVISION No. 2

Anchorage Recording Precinct, Alaska, and that the improvements situated thereon are within the property lines and do not overlap or encroach on the property lying adjacent thereto, that no improvements on the property lying adjacent thereto encroach on the premises in question and that there are no roadways, transmission lines or other visible easements on said property except as indicated hereon.

Dated at Anchorage, Alaska

this 26th day of AUGUST, 2021.

FRED WALATKA & ASSOCIATES, L.L.C.
Engineers and Surveyors

907-248-1666



3-2-2023

FB 22-5, pg 28

FB 21-5, pg 48-49

BE

SCALE: 1"= 30'

EASEMENTS OF RECORD, OTHER THAN THOSE SHOWN ON THE RECORDED PLAT ARE NOT SHOWN HEREON UNLESS OTHERWISE NOTED.

This drawing is a representation of conditions found at the time the mortgage location survey was performed. This document does not constitute a boundary survey and is subject to any inaccuracies that a subsequent boundary survey may disclose. The information contained on this drawing shall not be used to establish any fence, structure or other improvements. This drawing shall only be used for a single property transaction. Use of this drawing by the original client or by others at a later date without the consent of Elizabeth L. Walatka is a violation of Federal Copyright law. Unless gross negligence is discovered, the liability extent of the preparer is limited to the amount of fees collected for services in preparation of this product.