


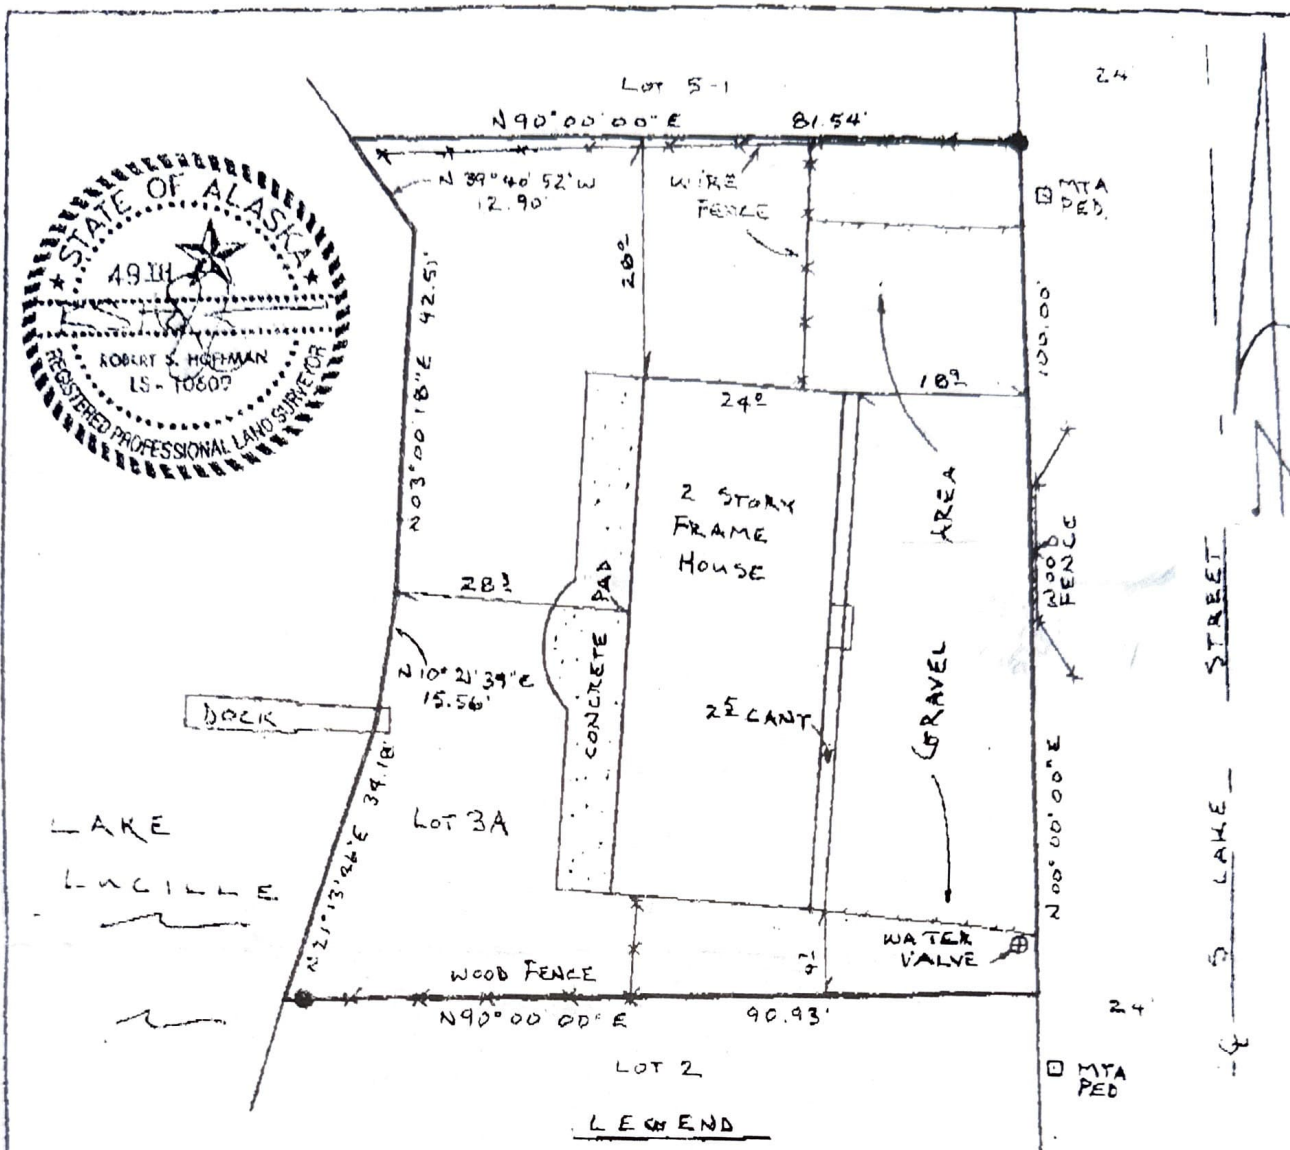

AS-BUILT

MORTGAGE SURVEY CERTIFICATE:

I HEREBY CERTIFY THAT I, OR SOMEONE UNDER MY DIRECT SUPERVISION, HAVE PERFORMED A MORTGAGEE'S INSPECTION ON THE FOLLOWING DESCRIBED PROPERTY, AND THAT NO ENCROACHMENTS EXIST EXCEPT AS INDICATED.

MORTGAGE SURVEY

LOT 3A BLOCK 88 KENNEDY ADDITION

526Y BO8 LOC3A

PALMER RECORDING DISTRICT, ALASKA

NOTE: ALL BEARINGS AND DISTANCES SHOWN ARE RECORD.
UNLESS OTHERWISE NOTED.

BULL MOOSE SURVEYING

ROBERT S. HOFFMAN
200 HYGRADE LANE, WASILLA, ALASKA 99654
(907) 357-6857 FAX (907) 357-6977

IT IS THE RESPONSIBILITY OF THE OWNER TO DETERMINE THE EXISTENCE OF ANY EASEMENTS, COVENANTS, OR RESTRICTIONS WHICH DO NOT APPEAR ON THE RECORDED SUBDIVISION PLAT. UNDER NO CIRCUMSTANCES SHOULD ANY DATA SHOWN BE USED FOR CONSTRUCTION OR FOR ESTABLISHING BOUNDARY OR FENCE LINES.

DRAWN BY: R. S. H.	DATE OF SURVEY: 8-7-06	PLAT # OR SERIAL # PLAT 2002-94	REVISION	BY	DATE
CHECKED BY: W. C. H.	SEC. 10	TWP. 23N	RNG. 8W	SCALE: 1"=20'	PREPARED FOR: BRETT YOUNG