


AS-BUILT SYSTEM DETAILS/SITE PLAN

Permit DSP241046

T12N R3W SEC 21 LOT 32D


PID# 015-273-33

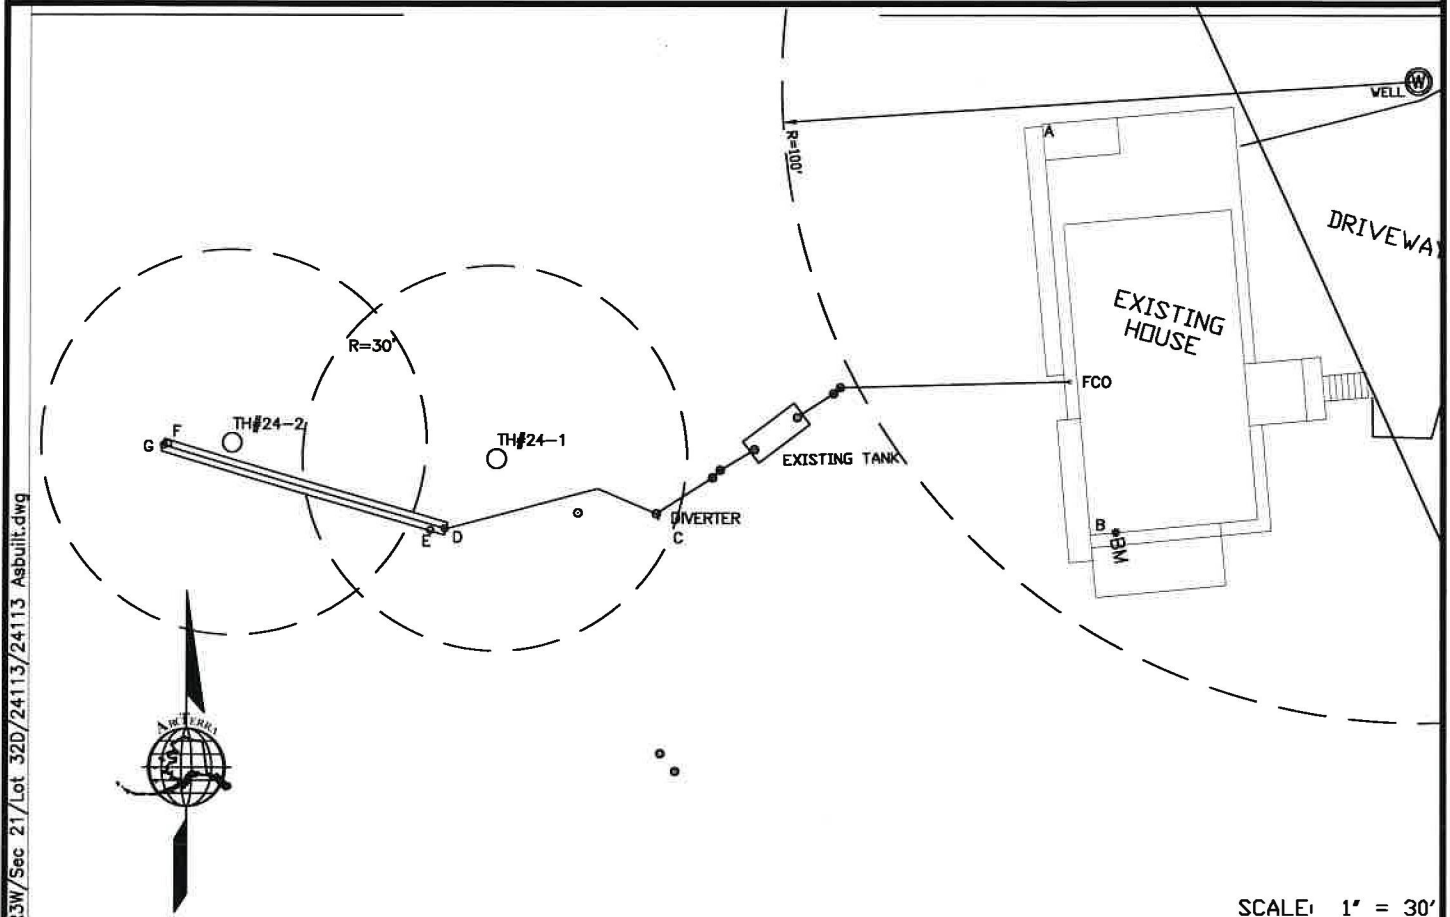

SCALE: 1" = 30'

Volumes/ArcTerra Shared/Storage/Well And SEPTIC - Filed By Legal/Seward Meridian/T12N R3W/Sec 21/Lot 32D/24113/24113 Asbuilt.dwg

- A-C=85.5'
- B-C=68.0'
- A-D=112.9'
- B-D=101.3'
- A-E=114.9'
- B-E=103.6'
- A-F=145.5'
- B-F=145.1'
- A-G=146.3'
- B-G=145.7'

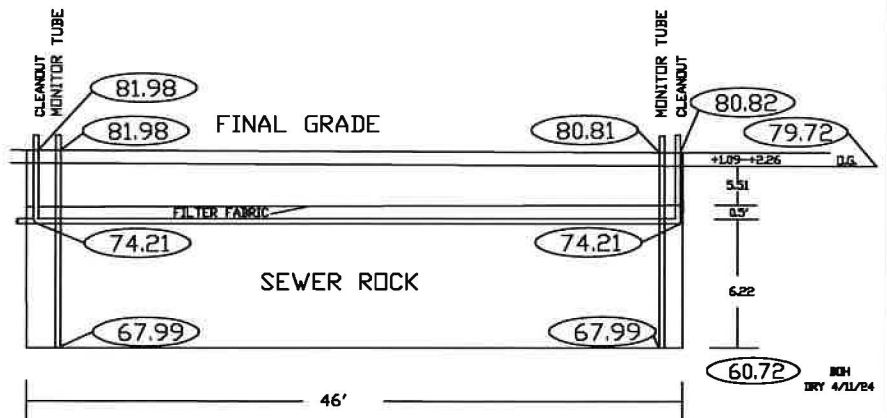

SCALE: NTS



PREPARED FOR:

MICHAEL VECHTER &
RACHEL GREGORY
11000 ELMORE RD
ANCHORAGE, AK

FIELD BOOKS	COMPUTED:
BOUNDARY: N/A	DRAWN: KSD
STAKING: N/A	CHECKED: KMD
ASBUILT: HOLT	DATE: 4/16/24
DWG. FILE:	GRID: SW2635
ACAD FILE: FILE	JOB No.: 24113

