


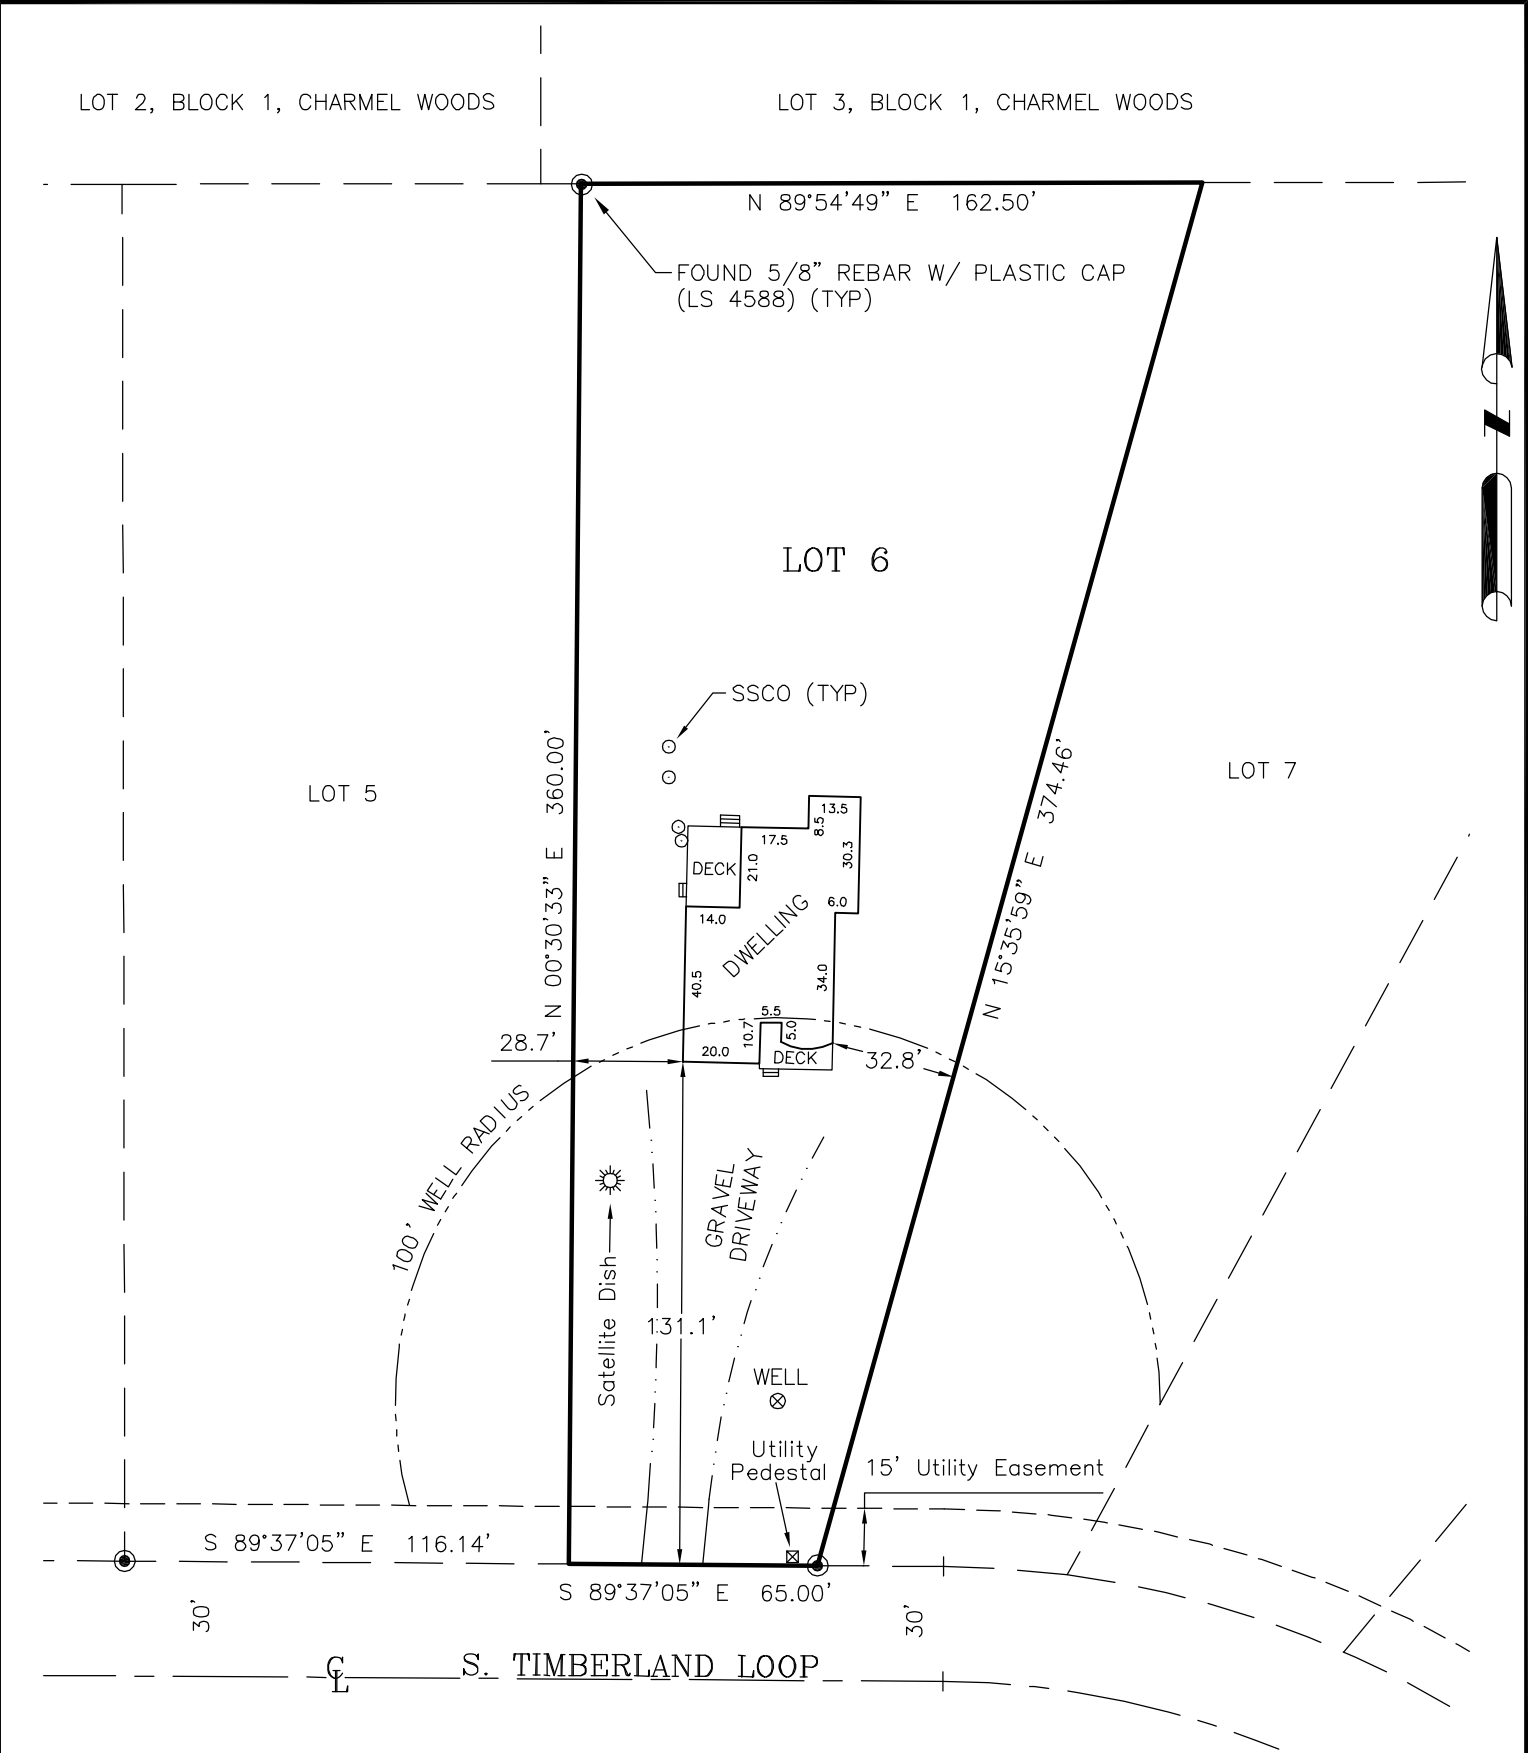

NOTES:

1. UTILITIES OTHER THAN THOSE SHOWN MAY EXIST ON THIS SITE. ONLY THOSE UTILITIES SEEN ON THE DATE OF SURVEY ARE SHOWN HEREON.
2. IT IS THE RESPONSIBILITY OF THE OWNER TO DETERMINE THE EXISTENCE OF ANY EASEMENTS, COVENANTS, OR RESTRICTIONS WHICH DO NOT APPEAR ON THE RECORDED SUBDIVISION PLAT.
3. THIS SURVEY WAS PREPARED IN ACCORDANCE WITH A.S.P.L.S. MORTGAGE SURVEY STANDARDS. THIS SURVEY DOES NOT CONSTITUTE A BOUNDARY SURVEY AND IS SUBJECT TO ANY INACCURACIES THAT A SUBSEQUENT BOUNDARY SURVEY MAY DISCLOSE. UNDER NO CIRCUMSTANCES SHOULD ANY DATA SHOWN BE USED TO CONSTRUCT ANY FUTURE STRUCTURE, FENCE, OR ANY OTHER IMPROVEMENTS.
4. ALL BEARINGS AND DISTANCES SHOWN ARE RECORD, UNLESS OTHERWISE NOTED.

ASBUILT SURVEY

©BULL MOOSE SURVEYING 2018

LOT 6, BLOCK 7, CAPTAIN'S RIDGE SUBDIVISION – PHASE II

PALMER RECORDING DISTRICT, ALASKA			REVISION	BY	DATE
BULL MOOSE SURVEYING ROBERT S. HOFFMAN 200 HYGRADE LANE, WASILLA, ALASKA 99654 (907) 357-6957 bob@bullmoosesurveying.com VISIT US AT BULL MOOSE SURVEYING.COM			MORTGAGE SURVEY CERTIFICATE: I HEREBY CERTIFY THAT I, OR SOMEONE UNDER MY DIRECT SUPERVISION, HAVE PERFORMED A MORTGAGEE'S INSPECTION ON THE FOLLOWING DESCRIBED PROPERTY, AND THAT NO ENCROACHMENTS EXIST EXCEPT AS INDICATED.		
DRAWN BY: RSH	DATE OF SURVEY: 11/12/2018		PREPARED FOR: <i>JODY MORRIS</i>		
CHECKED BY: SES	SECTION 27	TWP. 17N	RANGE 2W S.M.	SCALE: 1"=50'	PLAT #92-1

