


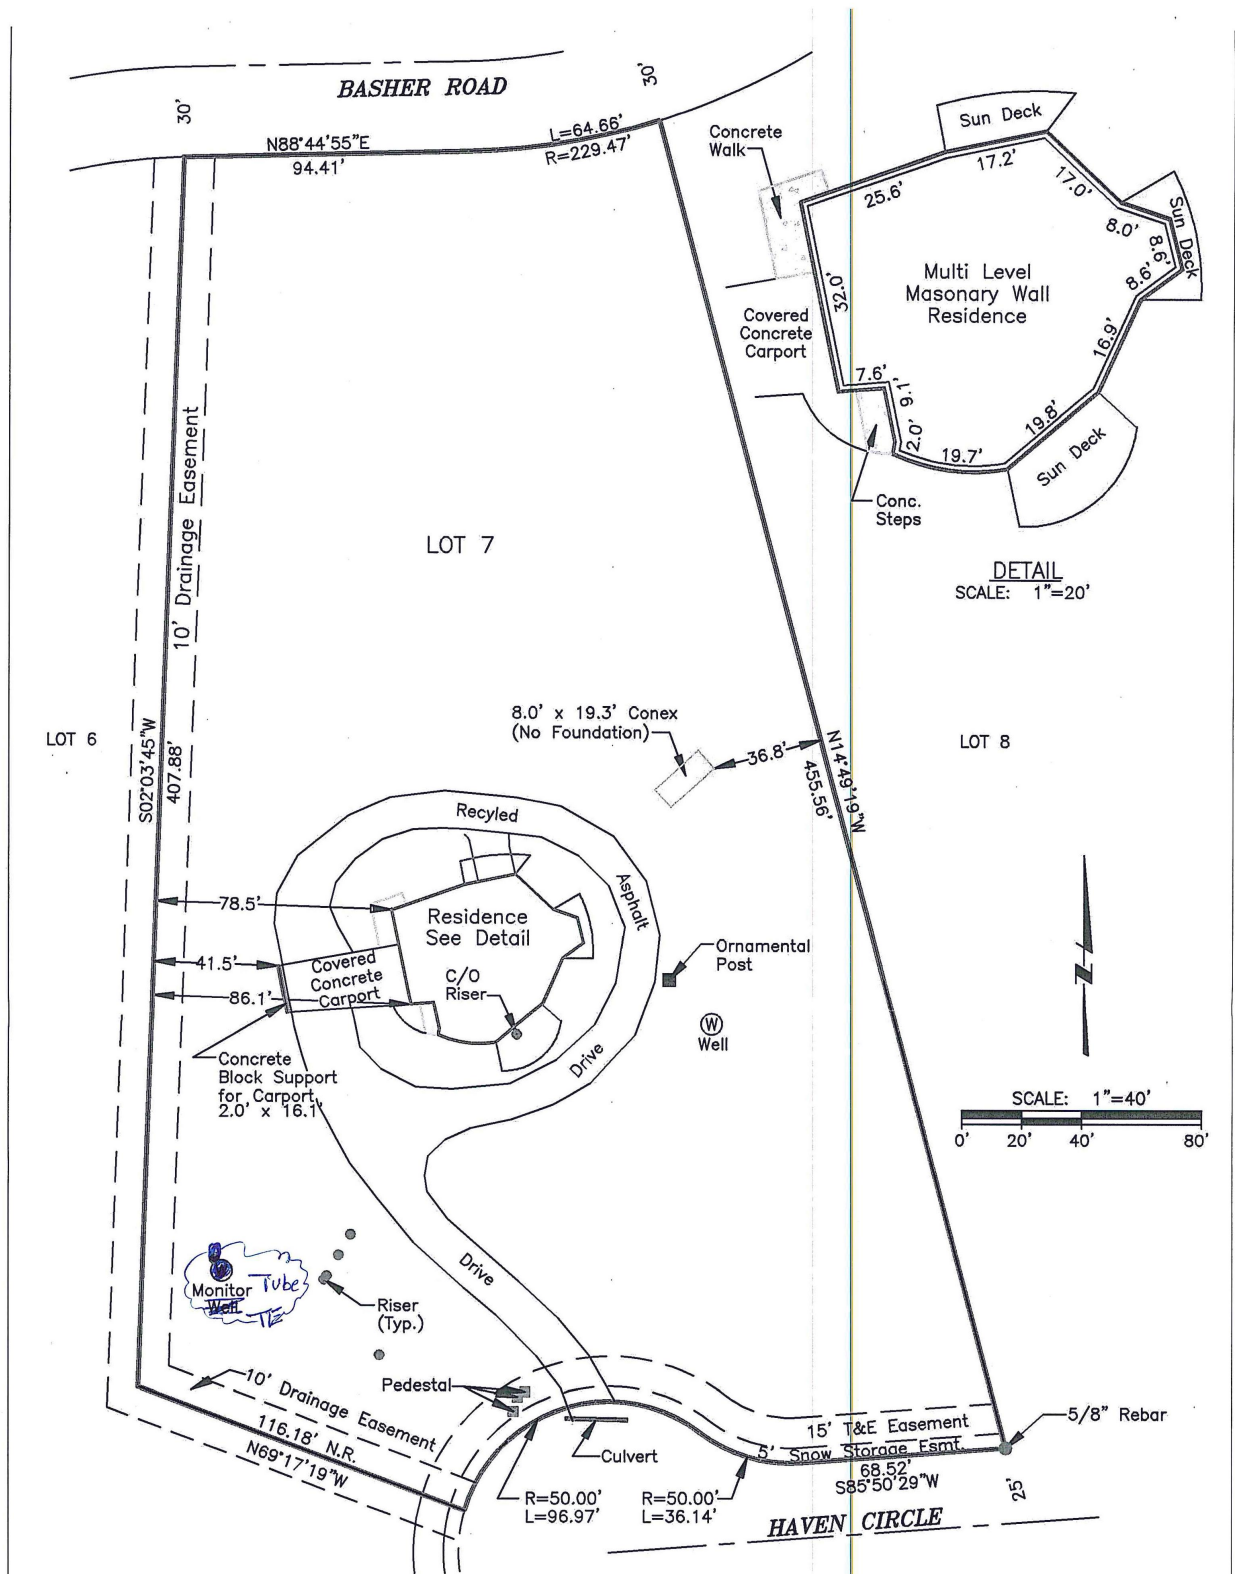

NOTES:

Dimensions are measured to the masonry wall.
N.R.—Not Radial



I hereby certify that an accurate survey of the following described property:

HILLSIDE NORTH SUBDIVISION (2001-176) ADDN. NO. 9
LOT 7

was made on October 20, 2020 and that the improvements situated thereon are within the property lines and do not overlap or encroach on the property lying adjacent thereto, that no improvements on the property lying adjacent thereto encroach on the premises in question and that there are no roadways, transmission lines or other visible easements on said property except as indicated hereon. Easements other than those shown on the record plat may not appear on this drawing.

Anchorage Alaska, this 17th day of November 2020.

PREPARED FOR:

HARRY HAYWOOD

AS-BUILT

DWN. JSP	DATE 11/17/2020	GRID SW 2142
FILE NO. 202015	F.B. CONTROLLER	JOB NO. 202028

**KARABELNIKOFF
SURVEYING** (907) 337-3434