
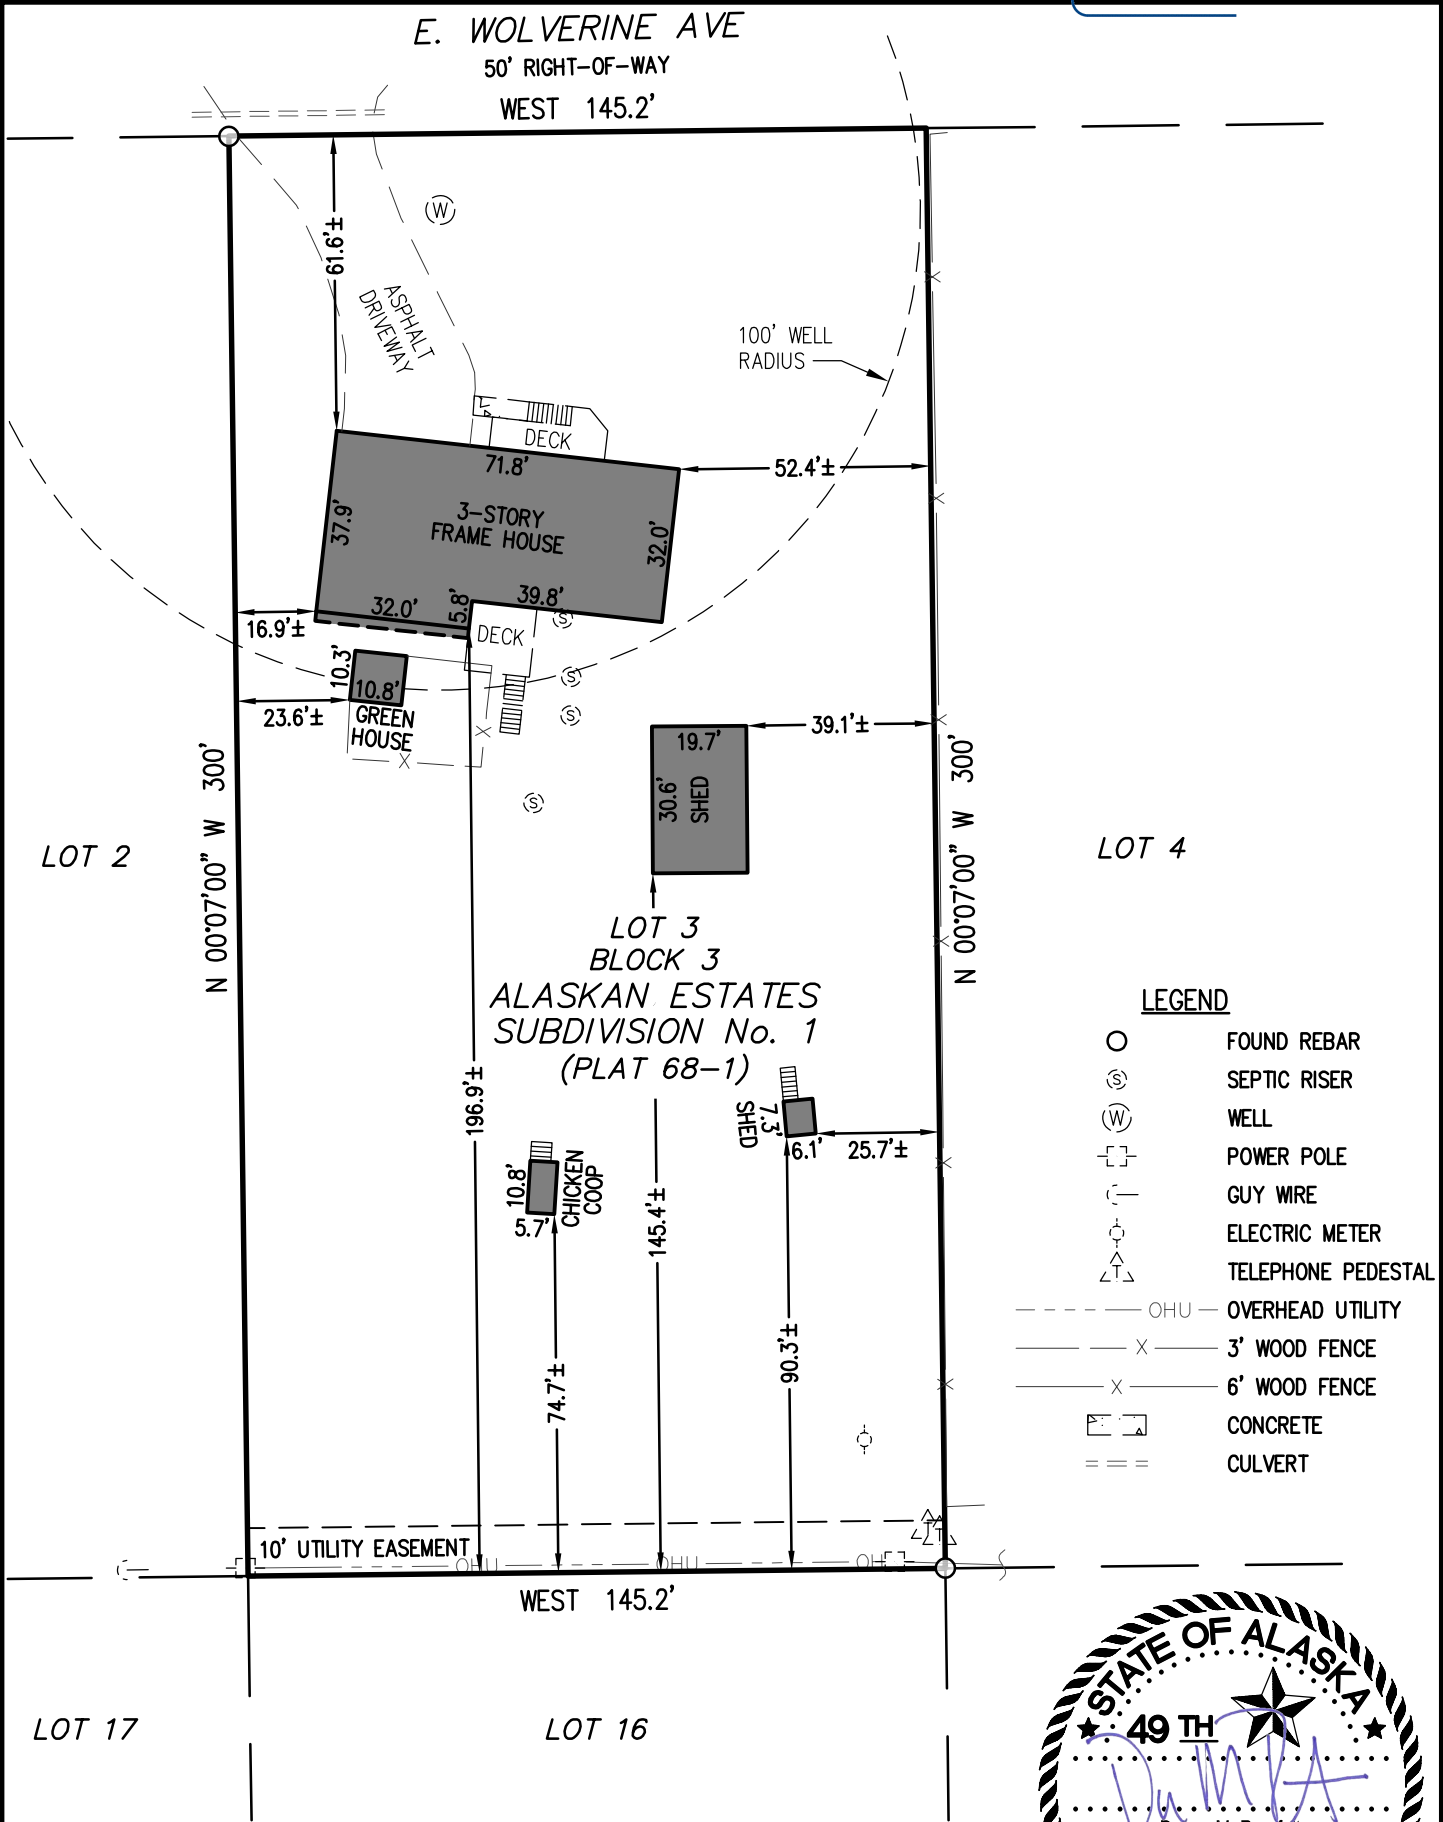


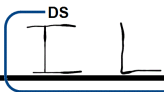


LEGEND

- FOUND REBAR
- Ⓢ SEPTIC RISER
- Ⓦ WELL
- ⌈⌋ POWER POLE
- GUY WIRE
- ⊙ ELECTRIC METER
- ⚡ TELEPHONE PEDESTAL
- OHU --- OVERHEAD UTILITY
- X — 3' WOOD FENCE
- X — 6' WOOD FENCE
- ▢ CONCRETE
- == CULVERT

NOTES

- DIMENSIONS ARE RECORD PER PLAT 68-1.
- UTILITIES OTHER THAN THOSE SHOWN MAY EXIST.
- THIS SURVEY DOES NOT CONSTITUTE A BOUNDARY SURVEY AND IS SUBJECT TO ANY INACCURACIES THAT A SUBSEQUENT BOUNDARY SURVEY MAY DISCLOSE. UNDER NO CIRCUMSTANCES SHOULD ANY DATA SHOWN BE USED TO ESTABLISH ANY FENCE, STRUCTURE OR ANY OTHER IMPROVEMENTS.
- ALL VISIBLE ABOVE GROUND FEATURES OF THE EXISTING SEPTIC SYSTEM WERE LOCATED AT THE TIME OF SURVEY AND SHOWN HERE ON.
- DISTANCE FROM WELL TO FIRST SEPTIC TANK CLEANOUT= 100.96'

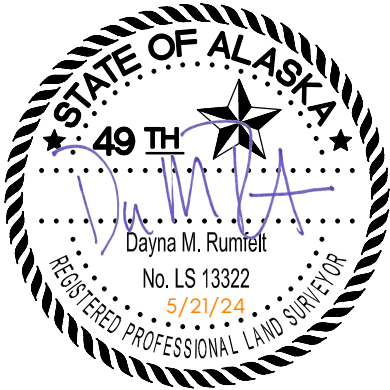



ASBUILT – NO CORNERS SET THIS DATE

I HEREBY CERTIFY THAT I HAVE PERFORMED A SURVEY OF

LOT 3, BLOCK 3, ALASKAN ESTATES SUBDIVISION No. 1, PLAT No. 68-1, PALMER RECORDING DISTRICT, ALASKA,

AND THAT THE IMPROVEMENTS AS DEPICTED HEREON EXIST AS SHOWN IN RELATION TO THE PROPERTY LINES. EASEMENTS OF RECORD OTHER THAN THOSE SHOWN ON RECORDED PLAT No. 68-1 ARE NOT SHOWN HEREON UNLESS OTHERWISE NOTED.

DATE: 5/21/2024	FB: 2024-2
GRID: WA07	DRAWN: CJ/SPK
SCALE: 1" = 40'	FILE: 24-101AB

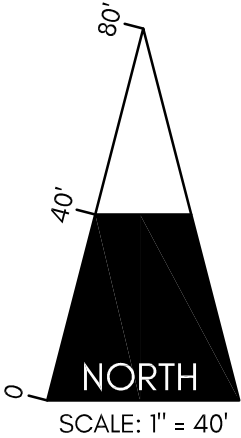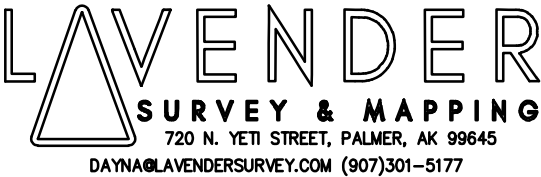

ORIGINAL SIZE: LEGAL