


LANTECH
LAND & CONSTRUCTION SURVEYORS-PLANNERS-ENGINEERS
440 WEST BENSON BLVD. # 103
ANCHORAGE, ALASKA 99503 562-5291 (fax) 561-8626
WO#2002-L-445A 1"=20' SEPT. 10, 2002 JZW

AS-BUILT OF: LEGAL DESCRIPTION:
LOT 5,
LAZY ACRES SUBDIVISION

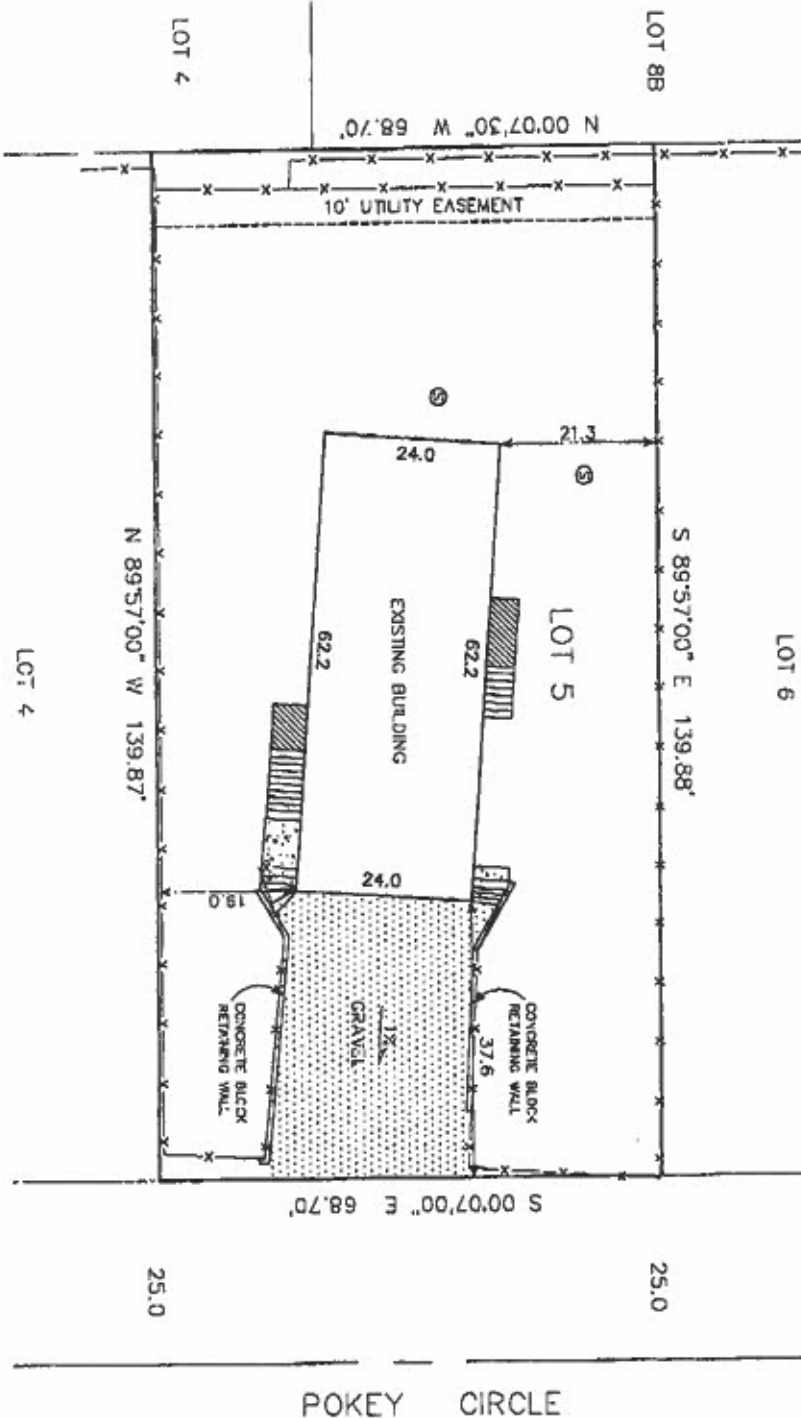

POKEY CIRCLE



DESIGNED BY: **KEITH F. ACER**
WITH PRUDENTIAL JACK WHITE
SURVEY CERTIFICATE: LANTECH has conducted a physical survey of this property as shown on this drawing and that the improvements situated thereon are within the property lines and no encroachments exist other than noted.
EXCLUSION NOTE: It is the owner's responsibility to determine the existence of any easements, covenants, or restrictions which do not appear on the recorded subdivision plat. NOTE: Under no circumstances should any data hereon be used for construction or for establishing property lines.

LEGEND: SET FND
1/8\"/>