


FOR INFO
PURPOSE

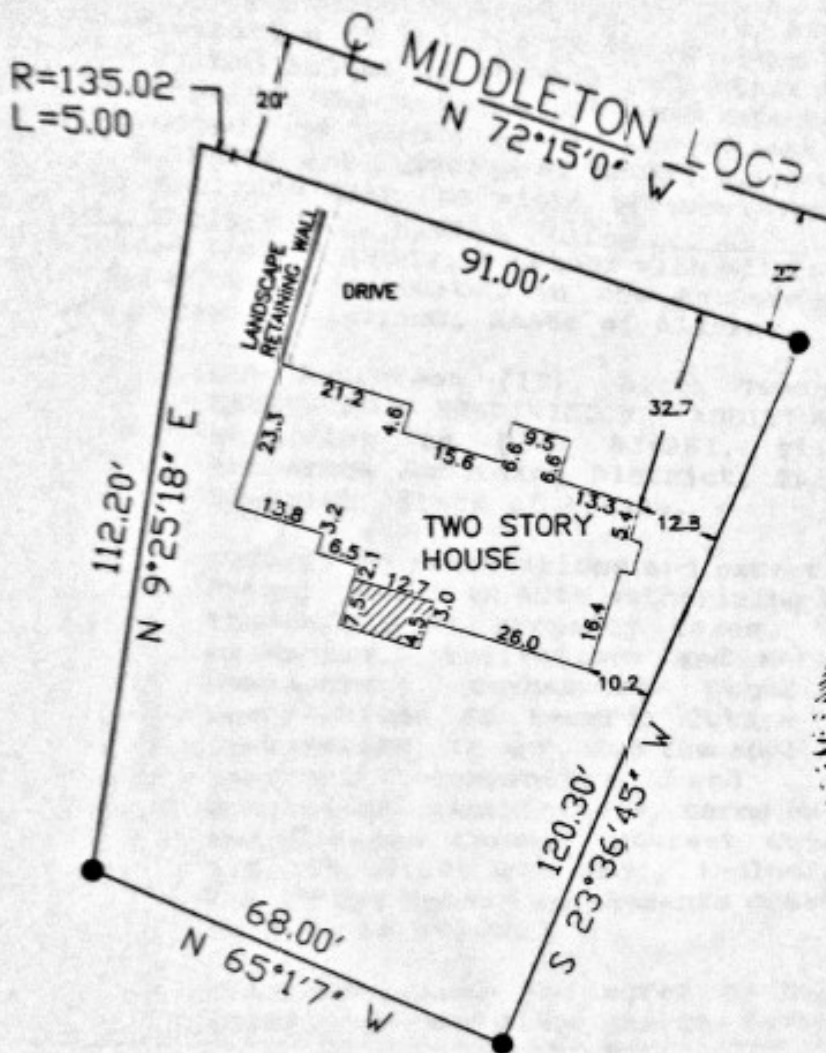

LEGEND: SET FOUND

5/8" REBAR

3.25" AL.MON.

HUB AND TACK

FENCE

WOOD DECKS

SEPTIC STANDPIPES

WATER WELL

**EAGLE RIVER
ENGINEERING SERVICES**
P.O. Box 773294
10421 VFW Drive
Eagle River, Alaska 99577
(907) 694-5195 FAX: (907) 694-3297

ASBUILT SURVEY
LOT 17 BK20

OWNER: WHITESIDE
DESCRIPTION: N/A

SCALE: 1"=30'
DATE: 7/17/97
BY: DCF
SHEET: 1 of 1
ERES Project Number: 97-037
CADD File Name: 97-037

I hereby certify that I have surveyed the following described property: Lot 17, Blk 20, Eaglewood Sub. #4 Anchorage Recording Precinct, Alaska, and that no encroachments exist except as indicated. It is the responsibility of the owner to determine the existence of any easements, covenants, or restrictions. Under no circumstances should any restrictions be placed on the recorded subdivision plat. Establishing boundary res.