


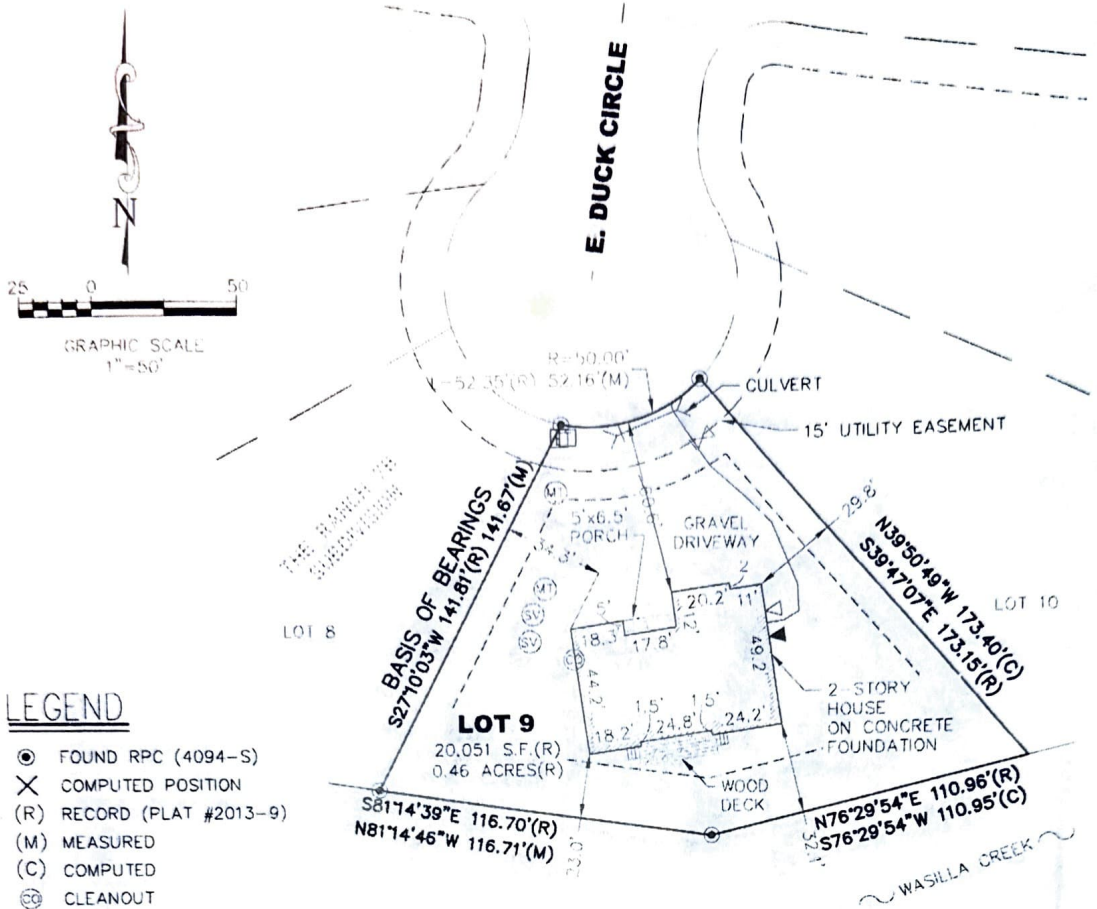

F.R. BELL & ASSOCIATES

THIS DRAWING REPRESENTS A MORTGAGE LOCATION SURVEY PREPARED IN ACCORDANCE WITH THE ASPLS MORTGAGE LOCATION SURVEY STANDARDS.

THIS MORTGAGE LOCATION (AS-BUILT) SURVEY IS A REPRESENTATION OF THE CONDITIONS THAT WERE FOUND AT THE TIME THE LOCATION SURVEY WAS PERFORMED AND DOES NOT CONSTITUTE A BOUNDARY SURVEY AND IS SUBJECT TO ANY INACCURACIES THAT A SUBSEQUENT BOUNDARY SURVEY MAY DISCLOSE.

INFORMATION CONTAINED HEREON SHALL NOT BE USED TO ESTABLISH ANY FENCE, STRUCTURE, OR OTHER IMPROVEMENTS.




AS-BUILT SURVEY

PREPARED FOR: HUBBARD ENTERPRISES

DRAWN BY: RLW	FIELD BOOK: FRB-2013-02
CHECKED BY: BMW	MSB MAP#: WA 08
JOB NO.: 2013-1666.01	DATE: 8-12-13
SCALE: 1"=50'	

93986. 06

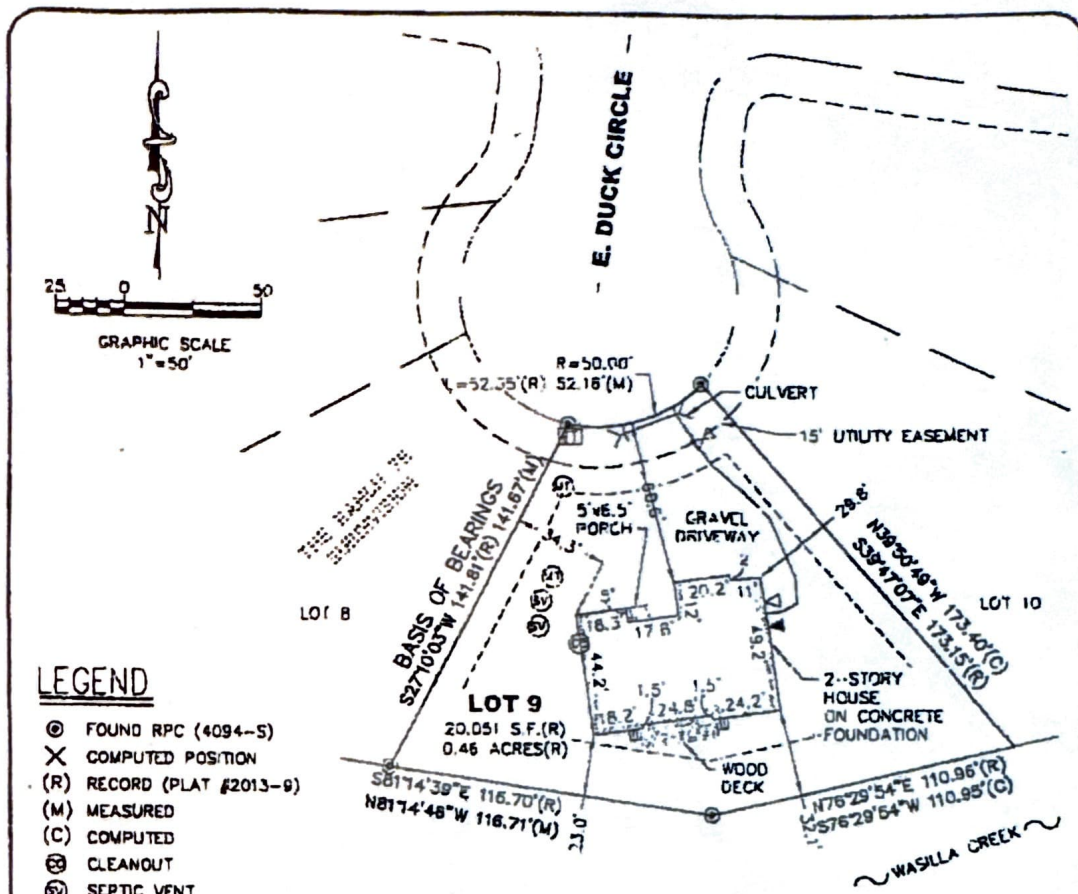

LEGEND

- ⊙ FOUND RPC (4094-S)
- ✕ COMPUTED POSITION
- (R) RECORD (PLAT #2013-9)
- (M) MEASURED
- (C) COMPUTED
- ⊙ CLEANOUT
- ⊙ SEPTIC VENT
- ⊙ MONITOR TUBE
- ⊙ TELEPHONE PEDESTAL
- ⊙ ELECTRIC BOX
- ▲ GAS METER
- △ ELECTRIC METER
- ⊙ WATER VALVE
- ✕ CULVERT

I HEREBY CERTIFY THAT AN ACCURATE SURVEY OF THE FOLLOWING DESCRIBED PROPERTY:

LOT 9 BLOCK 21

THE RANCH 7B SUBDIVISION
 WAS MADE ON AUG. 9, 2013
 AND THAT THE IMPROVEMENTS SITUATED THEREON ARE WITHIN THE PROPERTY LINES AND DO NOT OVERLAP OR ENCROACH ON THE PROPERTY LYING ADJACENT TO THE PREMISES IN QUESTION AND THAT THERE ARE NO ROADWAYS, TRANSMISSION LINES OR OTHER VISIBLE EASEMENTS ON SAID PROPERTY EXCEPT AS INDICATED HEREON.

THIS DRAWING REPRESENTS A MORTGAGE LOCATION SURVEY PREPARED IN ACCORDANCE WITH THE ASPLS MORTGAGE LOCATION SURVEY STANDARDS.

THIS MORTGAGE LOCATION (AS-BUILT) SURVEY IS A REPRESENTATION OF THE CONDITIONS THAT WERE FOUND AT THE TIME THE LOCATION SURVEY WAS PERFORMED AND DOES NOT CONSTITUTE A BOUNDARY SURVEY AND IS SUBJECT TO ANY INACCURACIES THAT A SUBSEQUENT BOUNDARY SURVEY MAY DISCLOSE.

INFORMATION CONTAINED HEREON SHALL NOT BE USED TO ESTABLISH ANY FENCE, STRUCTURE, OR OTHER IMPROVEMENTS.



AS-BUILT SURVEY

PREPARED FOR:

HUBBARD ENTERPRISES

DRAWN BY: RLW
 CHECKED BY: BMW

FIELD BOOK: FRB-2013-02

JOB NO.: 2013-1886.01

MSB MAP#: WA 08

SCALE: 1"=50'

DATE: 8-12-13

F.R. BELL & ASSOCIATES