


Lot 14



N00°01.5'E 157.5'

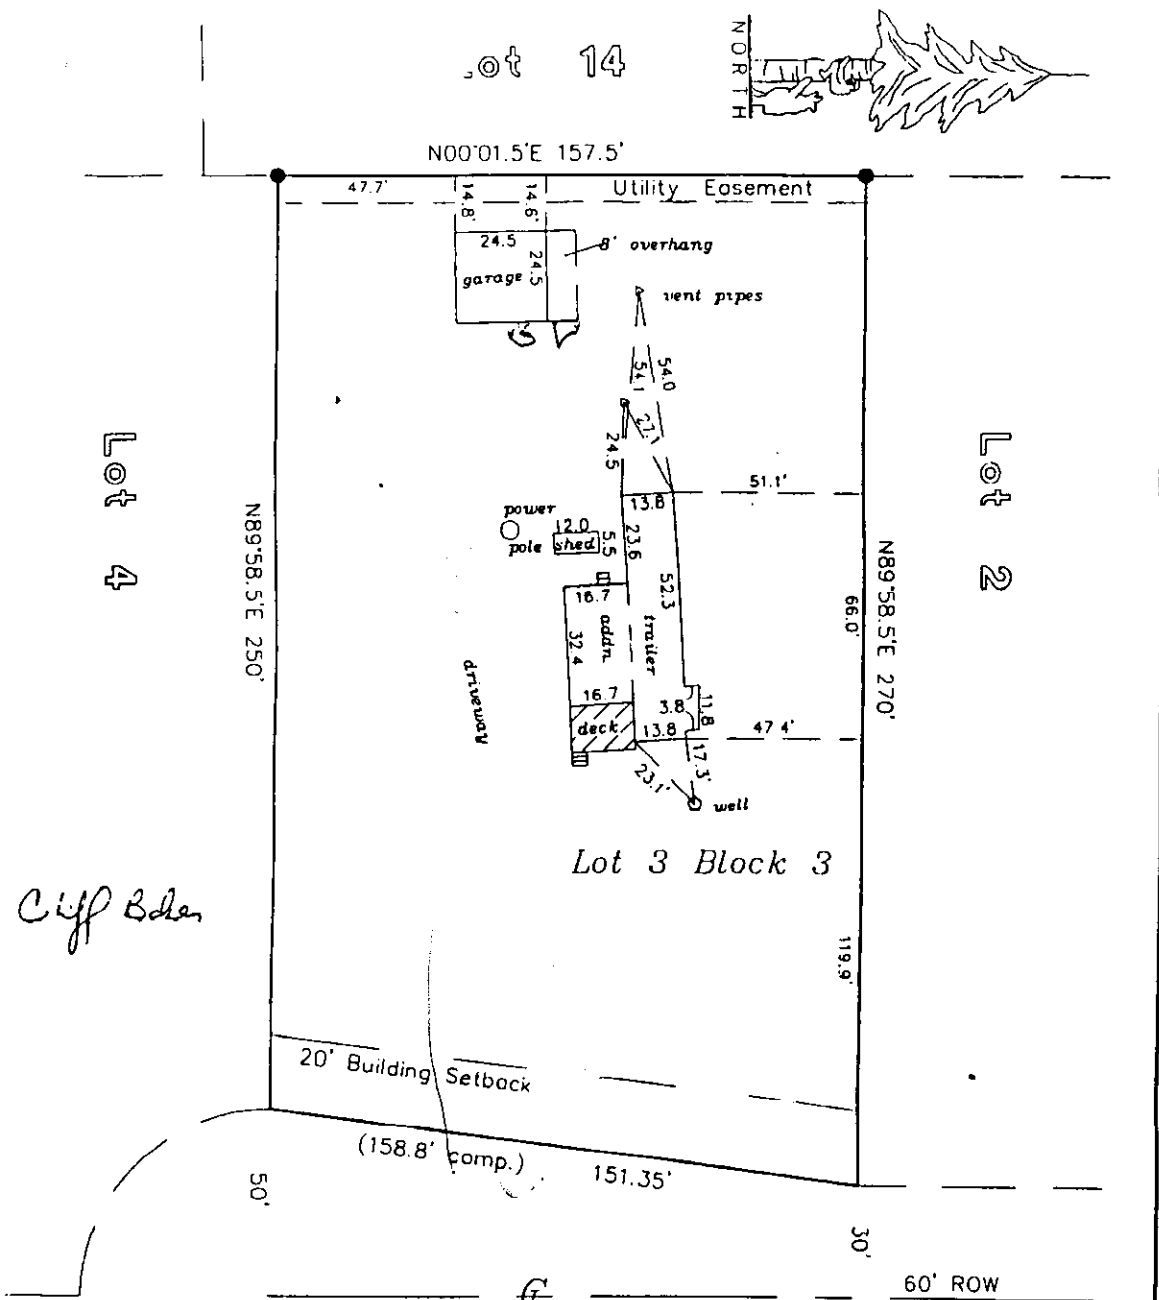

Cliff Bolen

Lot 3 Block 3

Ruby Circle

AS-BUILT CERTIFICATION

LEGEND

● Rebar/Pipe (found)

As-Built Certificate

I hereby certify that the improvements hereon exist as shown on the following described property:

Lot 3 Block 3

Knutsen Subdivision # 2

and that no encroachments exist except as indicated.

Exclusion Note:

It is the responsibility of the Owner to determine the existence of any easements, covenants, or restrictions which do not appear on the recorded subdivision plat. Under no circumstances should any data hereon be used for construction or for establishing boundary or fence lines.

Scale: 1" = 40'	F.B. #: 92-9, 2
Kenai	RECORDING DISTRICT
Mat: 76-116	Date: November 17, 1992
Drawn: CB	W.O. #: 92106
	Disk: Knutsen

INTEGRITY SURVEYS

HC 2 BOX 385
SOLDOTNA, ALASKA 99669
SURVEYORS 262-9461 PLANNERS