


TURNAGAIN PARKWAY



SCALE 1" = 30'

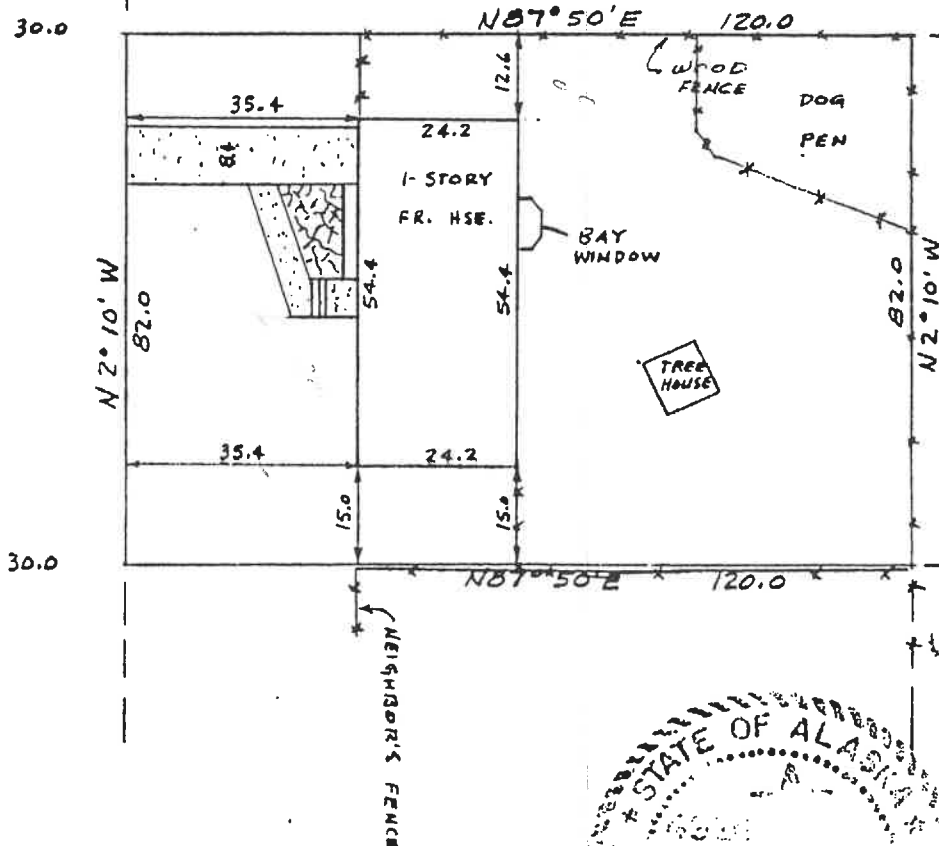

EASEMENTS OF RECORD, OTHER THAN THOSE SHOWN ON THE RECORDED PLAT, ARE NOT SHOWN HEREON.

AS BUILT

74B

I hereby certify that I have surveyed the following described property, Lot 13 Block 'H' TURNAGAIN HOMES SUBD. ANCH recording Precinct, Alaska, and that the improvements situated thereon are within the property lines and do not overlap or encroach on the property lying adjacent thereto, that no improvements on property lying adjacent thereto encroach on the premises in question and that there are no roadways, transmission lines or other visible easements on said property except as indicated hereon.

Anchorage, Alaska 22 JUNE 1974
RECERTIFIED 18 JUNE 1992 *F. Hildonan*

