


AS-BUILT PLOT PLAN
ON-SITE SEWAGE SYSTEM INSTALLATION RECORD
 Satisfies ORS 454.665

Property Owner Nick Neketin Permit No. 975 0073
 Location: Twp 13 S. R. 12 E. Sec. 21AD Tax Lot 2400

Scale Not Necessary

****SHOW ALL WELLS & SET BACKS TO PROPERTY LINE; HEADER PIPES; NORTH; & DWELLING AREA.****

Nick Neketin
 84766 Didion Ln.
 Milton-Freewater OH. 97862
 T13
 S12
 Sec. 21AD
 Tax lot 216

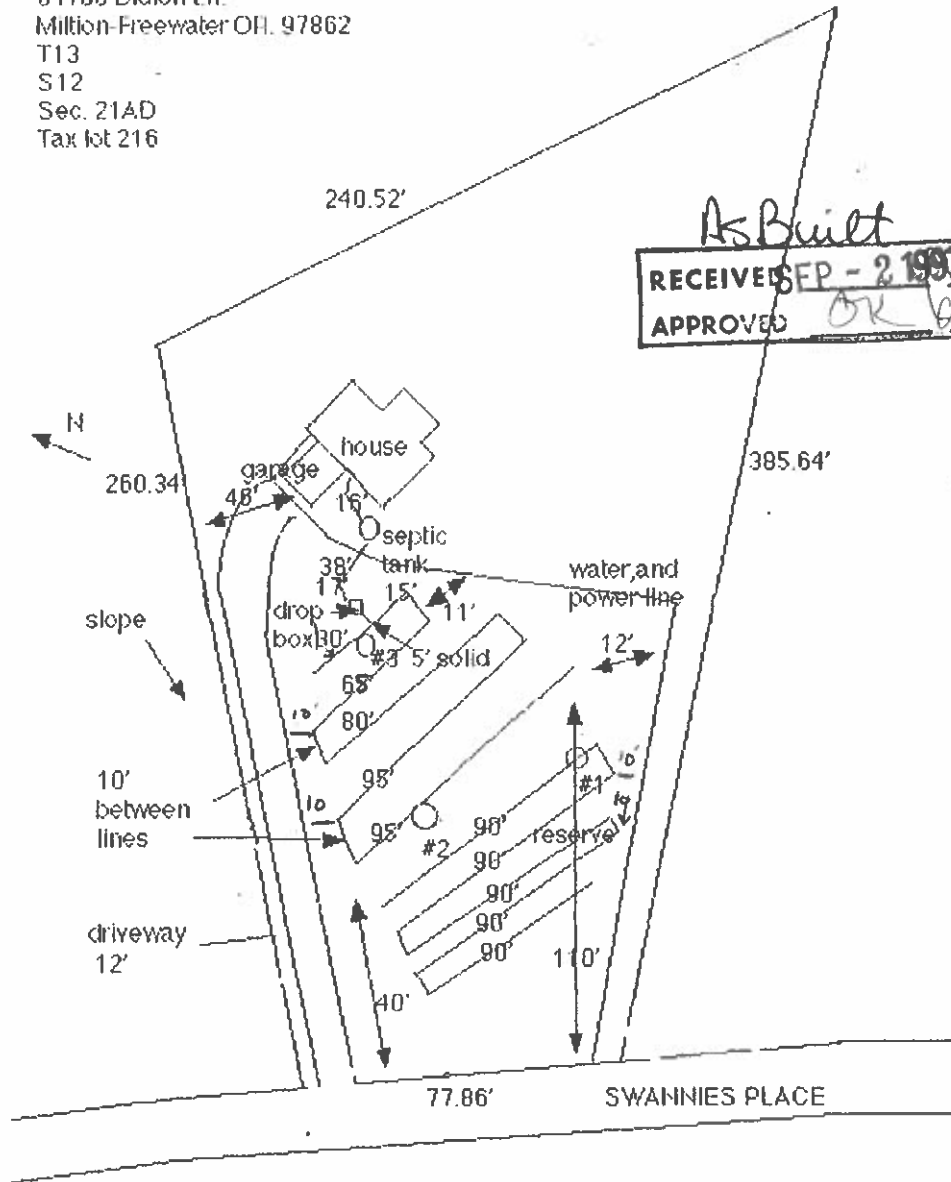

As Built
 RECEIVED SEP - 2 1997 MD
 APPROVED *OK*

ARE YOU READY FOR AN INSPECTION NOW? yes

"I certify that the construction and installation of this system was in accordance with the permit and rules of the Commission."

Back Street Const. Corp. Maureen Alley
 Installer's signature

35585
 DEQ License Number

Installer's Name and Address:
P.O. Box 350

Date System Completed:

Culver, Oregon 97734

8/29/97

Reminder: You also need to submit a Materials List and Watertightness test.