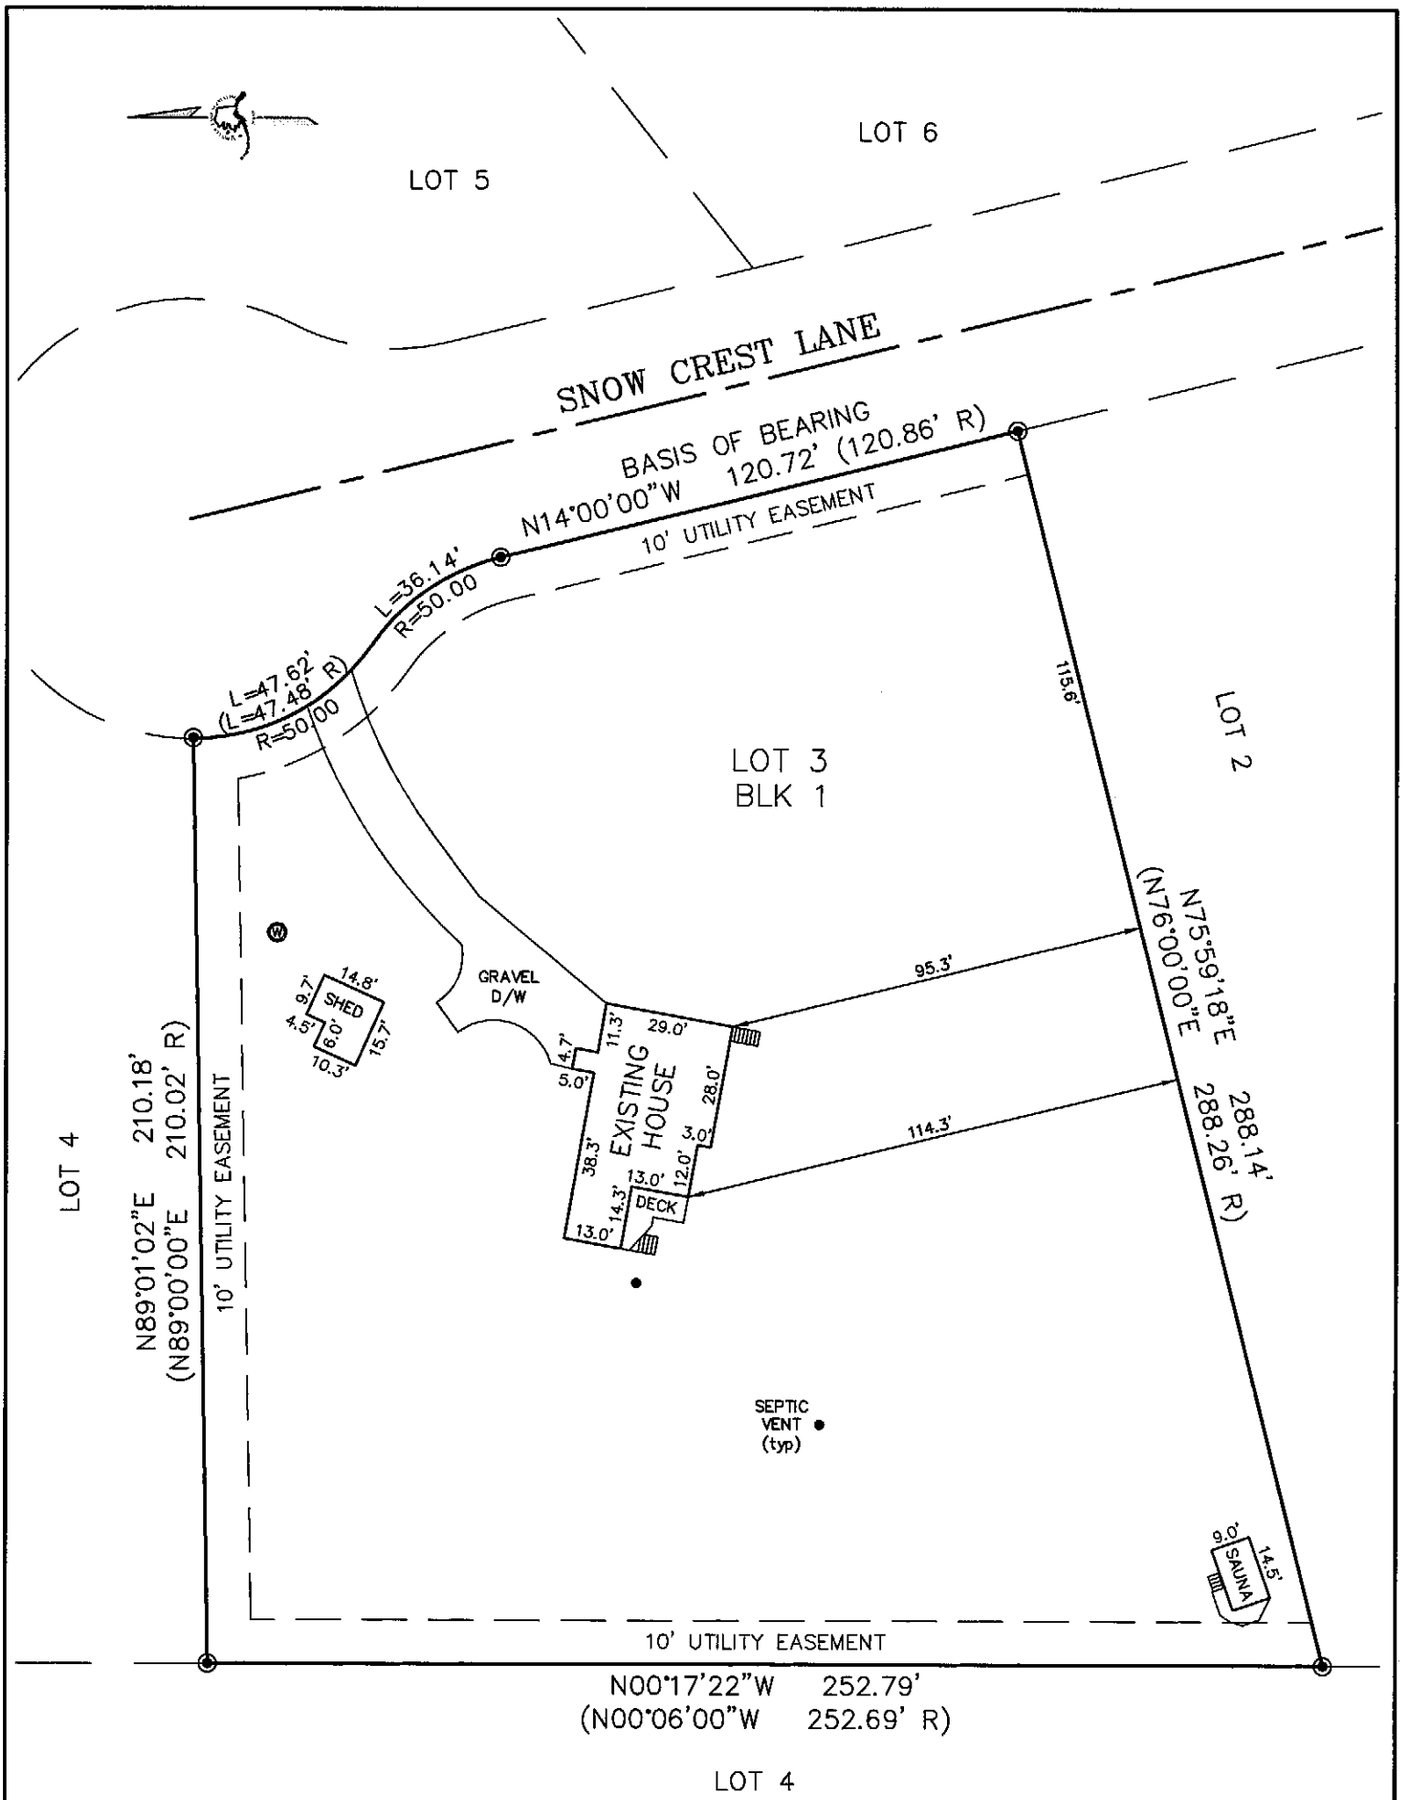

ANCHORAGE RECORDING DISTRICT, ALASKA

ASBUILT OF:
MOUNTAINSIDE VILLAGE SUBDIVISION
LOT 3 BLOCK 1 PLAT 79-177

◉ = FND 5/8" REBAR

SURVEY CERTIFICATE: I, John L. Schuller, Have conducted a physical survey of this property as shown on this drawing and that the improvements situated hereon are within the property lines and no enchroachments exist other than noted. Under no circumstance should any information on this drawing be used for construction of fences, structures, improvements, or for establishing boundary lines.

EXCLUSION NOTES: It is the owners responsibility to determine the existence of any easements, covenants, or restrictions which do not appear on the recorded subdivision plat.

WORK ORDER NUMBER:	DATE:	SCALE:	E-MAIL:
13–029	JULY 10, 2013	1"=30'	kndeng@ak.net
	DRAWN BY: / CHECKED BY: JLS	GRID NUMBER: 3439	BOOK/PAGE: 130152

STATE OF ALASKA
49TH
JOHN L. SCHULLER
LS-10408
7-10-13
Registered Professional Land Surveyor

SCHULLER LAND SURVEYING LLC
PROFESSIONAL LAND SURVEYING

1831 Talkeetna Street
Anchorage, Alaska 99508
(907) 227-1455 office
(907) 274-4992 fax